

CERTIFIED LAND CORNER RESTORATION


Index No. A-13

State of Wisconsin }
County of Lincoln } ss.

I Sheridan D. Schwark, do hereby certify that on the 12th day of April, 19 78, I found evidence of the Northwest corner of Section 3 Township 31, North, Range 6 East, Fourth, Principal Meridian, as described hereon; and that from this evidence I established a new monument and accessories as described hereon to perpetuate the original location of this corner.

Resident witnesses:

.....
.....
.....

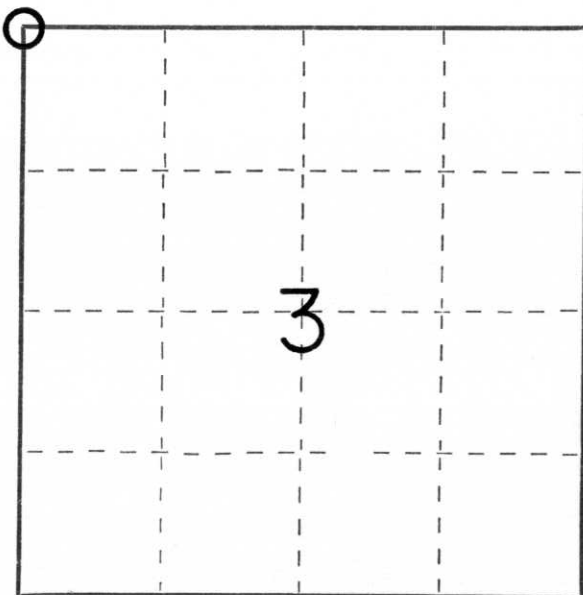

○ = Corner monument restored.

History of original corner establishment:

Date: June, 1851
Surveyor: James M. Marsh
Monument: Wood post
Witnesses: 11" Hemlock, N30°E 30 links
12" " S69°E 67 "
15" " S76°W 27 "

Description of corner evidence found:

We found an old 2" I.P. about 8" below the surface with a spike directly above it; the pipe had been used by W.R. Ottensman. He reported that it was found in place in 1971.

Description of monument and accessories I established to perpetuate the original location of this corner.

We set a Lincoln County Bernsten monument and the following witness monuments:
1 1/4" x 30" iron pipe set 3' east of power pole No. 3106-4E1, bearing, S83°W, 19.23'
1 1/4" x 30" iron pipe set 3' west of fence post and 18' west of power pole No. 3106-3W1 bearing N86°E, 28.95'
1 1/4" x 30" iron pipe set at the west edge of the blacktop road, bearing S6°W, 90.32'
1 1/4" x 30" iron pipe set at the east edge of the blacktop road, bearing, N3°E, 83.65'

Dated at Merrill, Wis., this 14th day of April, 19 78.

Signature Sheridan Schwark Title Registered Land Surveyor Registration No. S-1205
(County Surveyor, Registered Land Surveyor, or other duly authorized official)

Office of Register of Deeds, County of....., I hereby certify that the within instrument was filed in this office for record on the.....day of....., 19..... at.....o'clock..... M..

.....
(Register of Deeds)

By.....Deputy



2002 7 30



2002 7 30



