


U.S. PUBLIC LAND SURVEY MONUMENT RECORD

Note: This form is intended and designed to fulfill all requirements of Wisconsin Administrative Code, Chapter A-E 5.02, U.S. Public Land Survey Monument Record (3) (a) (b) (c) (d) (e) (f) (g) (h) (i). An additional sheet may be added if necessary to conform with said requirements.

(a) Corner location: Township 32 North
 Range 7 East ~~West~~

Town/~~City/Village~~ Merrill

County Lincoln

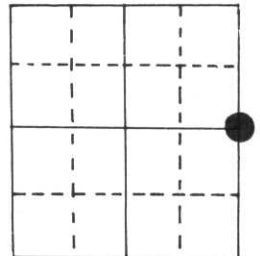

Section 22


(b) (f) (g) (h) Description of monument found at this corner and if it was accepted, state all evidence (material, testimonial, occupational, plats, records, other monuments) used as a basis for accepting. If not accepted or if nothing was found, state evidence used as basis for establishing location. If reestablished through lost corner proportionate methods, indicate all monuments, distances and directions used to establish.

Original in 1852, OBT's sugar 12" S82°W 7 lks., B W 26" S64°E 16 lks.

In 1937 there was a slight chance that Co. Surveyor Francis Fox could have set this location since there was evidence north & south of here, no records found.

In 1987 Seymour set aluminum Co. Bernsten monument buried 1' in center of road. Location is at midpoint on line between NE 22 & SE 22.

(c) (d) (e) Plan view of corner with ties to at least 4 witness monuments. If in disagreement with previously established corner, show the distances between the two corners and also indicate the ties to the disputed corner.

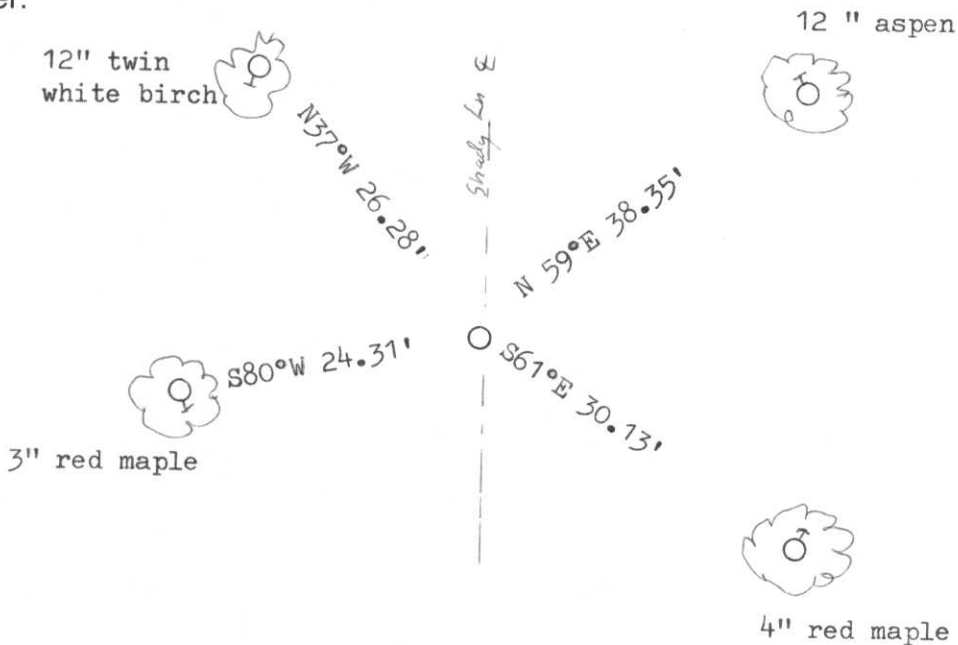

(i) I, Marvin E. Seymour
 (type or print name) certify that the corner location on this record was determined by me or under my direction and control and that this U.S. Public Land Survey Monument Record is correct and complete to the best of my knowledge and belief.

Marvin E. Seymour
 Signature
Dec. 4, 1987
 Date



0-17



19 2:07 PM



19 2:08 PM



19 2:10 PM