

CERTIFIED LAND CORNER RESTORATION

Index No. S-17

State of Wisconsin }
County of Lincoln } ss.

History of original corner establishment:

I Sheridan D. Schwark, do hereby certify that on the 5th day of August, 1977, I found evidence of the E 1/4 corner of Section 27 Township 32, North, Range 7 East, Fourth, Principal Meridian, as described hereon; and that from this evidence I established a new monument and accessories as described hereon to perpetuate the original location of this corner.

Date: April 1852
Surveyor: A. G. & F. S. Ellis
Monument: wood post
Witnesses: 10" Hemlock N 72°W, 24 links
13" Hemlock S 53°E, 8 links

Description of corner evidence found:

Found a 6" x 6" granite monument at the intersection of fences running South and West. The stone was above the ground ± 1 foot with a chiseled line running North and South. The monument was tilted to the Northeast.


Resident witnesses:

.....
.....
.....

Description of monument and accessories I established to perpetuate the original location of this corner.

We straightened the granite monument and witnessed it as follows:

- 3/4" x 30" round iron rod ± 1' SE of a triple 4" Maple
- 3/4" x 30" round iron rod ± 1' S of a 7" Poplar
- 3/4" x 30" round iron rod ± 1' SW of a 14" Ash
- 3/4" x 30" round iron rod ± 1' NW of a 12" Maple

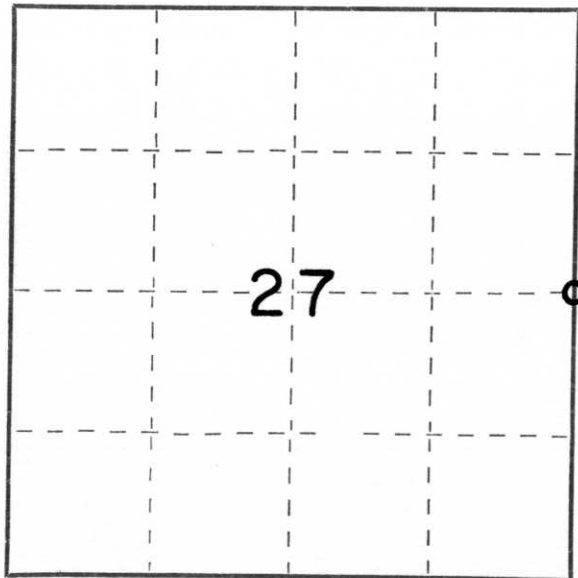

○ = Corner monument restored.

Dated at MERRILL, Wis., this 17TH day of AUGUST, 1977.

Signature Sheridan D. Schwark Title LAND SURVEYOR Registration No. S-1205
(County Surveyor, Registered Land Surveyor, or other duly authorized official)


Office of Register of Deeds, County of _____, I hereby certify that the within instrument was filed in this office for record on the _____ day of _____, 19____ at _____ o'clock _____ M.

.....
(Register of Deeds)

By _____ Deputy



8 1:13 PM

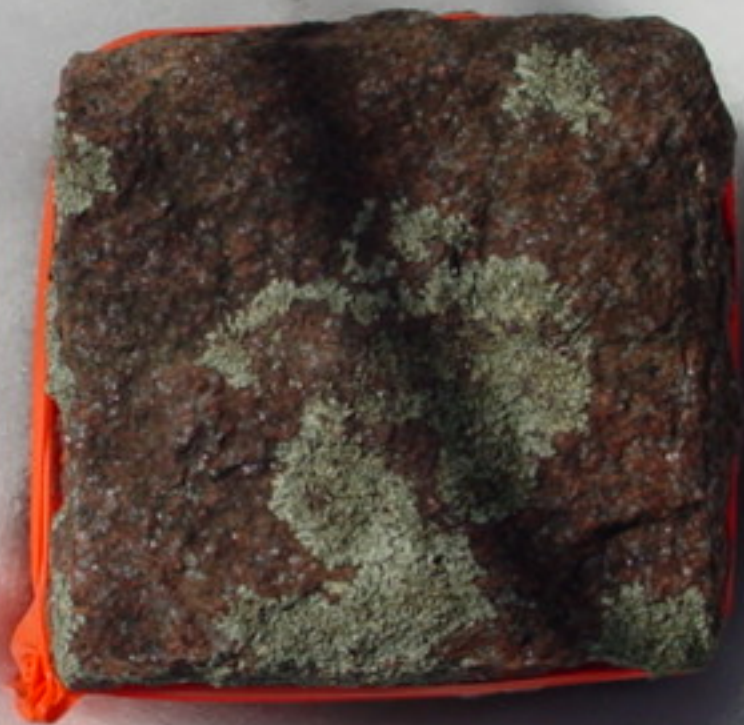

8 1:13 PM



8 1:16 PM