


CERTIFIED LAND CORNER RESTORATION

Index No. S-21

State of Wisconsin }
County of LINCOLN } ss.

History of original corner establishment:

I Chester J. Nowaczyk, do hereby certify that on the 3RD day of Aug, 1976, I found evidence of the W 1/4 corner of Sec. 25 Township 32 N., North, Range 7 E., Fourth, Principal Meridian, as described hereon; and that from this evidence I established a new monument and accessories as described hereon to perpetuate the original location of this corner.

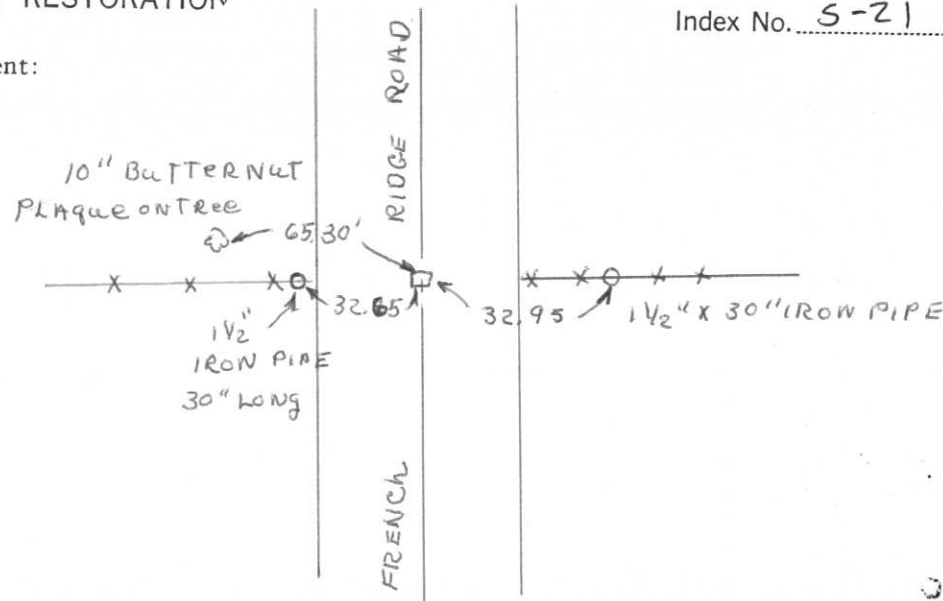


Description of corner evidence found:

Resident witnesses:

.....
.....
.....

Description of monument and accessories I established to perpetuate the original location of this corner.

FOUND 6" X 6" GRANITE MONUMENT AT ROAD SURFACE PLACED 1" IRON NEXT TO STONE TO THE NORTH

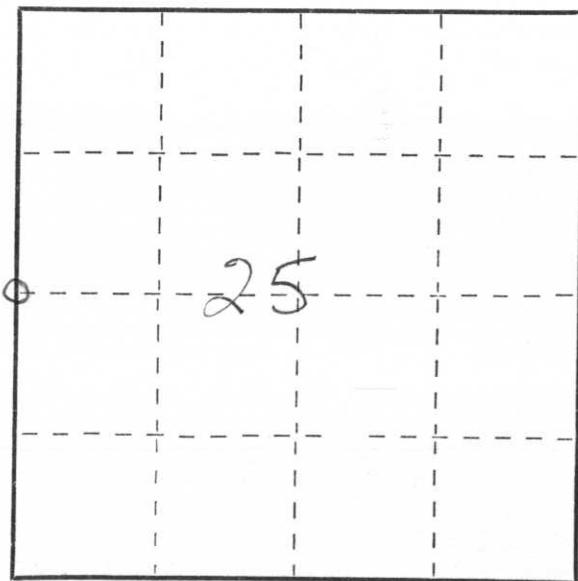

○ = Corner monument restored.

Dated at WAUSAU, Wis., this 9th day of Aug, 1976.

Signature Chester J. Nowaczyk Title SURVEYOR Registration No. 1193
(County Surveyor, Registered Land Surveyor, or other duly authorized official)

Office of Register of Deeds, County of _____, I hereby certify that the within instrument was filed in this office for record on the _____ day of _____, 19____ at _____ o'clock _____ M.

(Register of Deeds)

By _____ Deputy



2002 7 10



2002 7 10



2002 7 10



2002 7 10