


# U.S. PUBLIC LAND SURVEY MONUMENT RECORD

Note: This form is intended and designed to fulfill all requirements of Wisconsin Administrative Code, Chapter A-E 5.02, U.S. Public Land Survey Monument Record (3) (a) (b) (c) (d) (e) (f) (g) (h) (i). An additional sheet may be added if necessary to conform with said requirements.

(a) Corner location: Township 32 North  
 Range 7 East  
 Town/City/Village MERRILL  
 County LINCOLN

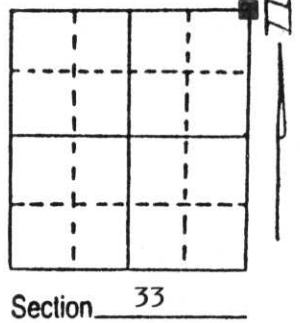


(b) (f) (g) (h) Description of monument found at this corner and if it was accepted, state all evidence (material, testimonial, occupational, plats, records, other monuments) used as a basis for accepting. If not accepted or if nothing was found, state evidence used as basis for establishing location. If reestablished through lost corner proportionate methods, indicate all monuments, distances and directions used to establish.

Found 8" X 8" Granite stone tipped. Straightened stone monument placed 3/4" X 30" iron bar on north side of stone. Included in traverse.

RECEIVED AT LINCOLN COUNTY  
 COURTHOUSE THIS 22nd DAY  
 OF Sept. 19 95  
Pat Prisher  
 TAX DESCRIPTION OFFICE

(c) (d) (e) Plan view of corner with ties to at least 4 witness monuments. If in disagreement with previously established corner, show the distances between the two corners and also indicate the ties to the disputed corner.

All witness corners set with 3/4" X 30" re-bars with Lincoln County caps.

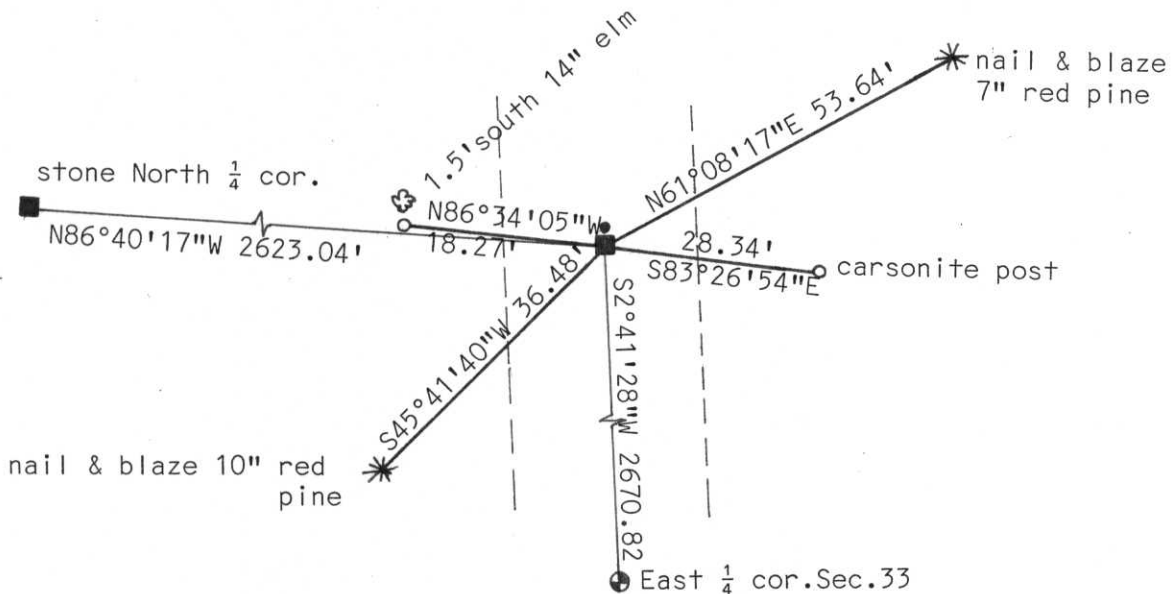

(i) I, Edwin R. Abendroth RLS No. S-798  
 (type or print name) certify that the corner location on this record was determined by me or under my direction and control and that this U.S. Public Land Survey Monument Record is correct and complete to the best of my knowledge and belief.



Edwin R. Abendroth 9-20-95  
 Signature Date

Index No. U-13