

CERTIFIED LAND CORNER RESTORATION


Index No. U-25

State of Wisconsin }
County of Lincoln } ss.

I, LaVerne H. Mosher, do hereby certify that on the 10th day of June, 1983, I found evidence of the Southeast corner of Section 25 Township 32, North, Range 7, Fourth, Principal Meridian, as described hereon; and that from this evidence I established a new monument and accessories as described hereon to perpetuate the original location of this corner.

Resident witnesses:

Terrance W. Fischer

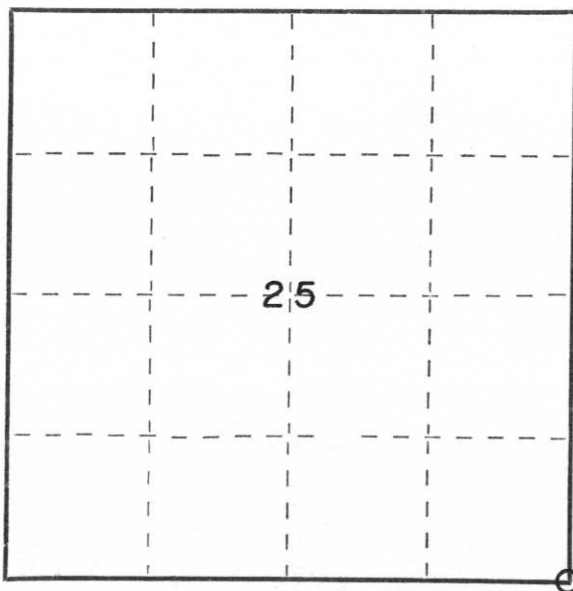

○ = Corner monument restored.

History of original corner establishment:

Notes of the original government survey indicate wood posts were set at all section and quarter-section corners. Stone monuments were subsequently placed at these corners during remonumentation surveys.

Description of corner evidence found:

Excavated with backhoe. At depth of 18 inches below blacktop roadway a 6" square Red Granite monument with cross was found. Set a 1"x30" iron pipe along East and South faces of stone to aid future location.

Description of monument and accessories I established to perpetuate the original location of this corner.

See sketch on reverse.



Dated at Schofield, Wis., this 13th day of June, 1983.

Signature LaVerne H. Mosher Title Registered Land Surveyor Registration No. S-1188
(County Surveyor, Registered Land Surveyor, or other duly authorized official)

Office of Register of Deeds, County of _____, I hereby certify that the within instrument was filed in this office for record on the _____ day of _____, 19____ at _____ o'clock _____ M.

(Register of Deeds)

By _____ Deputy

RECEIVED AT LINCOLN COUNTY
COURTHOUSE THIS 15 DAY
OF June 1983.
Pat Quinlan
TAX DESCRIPTION OFFICE

