

CERTIFIED LAND CORNER RESTORATION

Index No. W-5

State of Wisconsin }  
County of Lincoln } ss.

History of original corner establishment:

Date: April, 1852  
Surveyor: A.G. & F.S. Ellis  
Monument: Wood post  
Witnesses: 16" soft maple, S30°W, 17 links  
30" Pine S61°E, 28 links

I Sheridan D. Schwark, do hereby certify that on the 19th day of April, 1978, I found evidence of the West one-quarter corner of Section 32 Township 32, North, Range 7 East, Fourth, Principal Meridian, as described hereon; and that from this evidence I established a new monument and accessories as described hereon to perpetuate the original location of this corner.

Description of corner evidence found:

On February 2, 1978, we searched for the E 1/4 corner, Sec. 31, T32N, R7E. We found a down fence intersection running North, South, East, and West. We found down fence and posts to establish as best as possible the direction of the fence lines. We also went West across the Prairie River and found a continuation of the fence running West. A large rotted off post was found which appeared to be at the fence intersection. We set a 1 1/4" x 30" solid round iron rod at a point we determined to be the E 1/4 corner, after searching the intersection for any evidence of a existing corner. The corner we set fit all the fence lines well.


Resident witnesses:

.....  
.....  
.....

Description of monument and accessories I established to perpetuate the original location of this corner.

We replaced the 1 1/4" rod with a Lincoln County Berntsen monument having the following witness monuments:

- 5" Elm N15°E, 12.03'
- 7" Elm East, 18.85'
- 1" iron pipe, S15°W, 5.25'
- 1" iron pipe, West, 21.40'

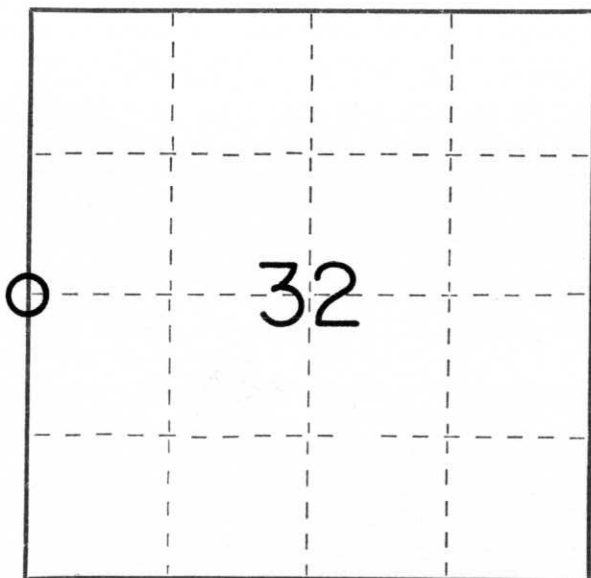

○ = Corner monument restored.

Dated at Merrill, Wis., this 20th day of April, 1978.

Signature Sheridan D. Schwark Title registered Land Surveyor Registration No. S-1205  
(County Surveyor, Registered Land Surveyor, or other duly authorized official)

Office of Register of Deeds, County of \_\_\_\_\_, I hereby certify that the within instrument was filed in this office for record on the \_\_\_\_\_ day of \_\_\_\_\_, 19\_\_\_\_ at \_\_\_\_\_ o'clock \_\_\_\_\_ M.

.....  
(Register of Deeds)

By \_\_\_\_\_ Deputy



8 3:27 PM



8 3:28 PM



8  
3:28 PM