


U.S. PUBLIC LAND SURVEY MONUMENT RECORD

Note: This form is intended and designed to fulfill all requirements of Wisconsin Administrative Code, Chapter A-E 5.02, U.S. Public Land Survey Monument Record (3) (a) (b) (c) (d) (e) (f) (g) (h) (i). An additional sheet may be added if necessary to conform with said requirements.

(a) Corner location: Township 32 North
 Range 7 East
 Town/City/Village SCHLEY
 County Lincoln

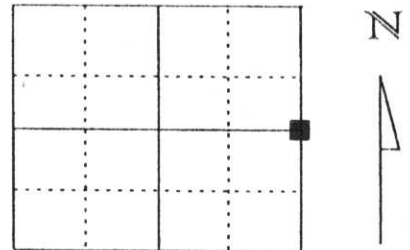

East $\frac{1}{4}$ corner, Section 36

(b) (f) (g) (h) Description of monument found at this corner and if it was accepted, state all evidence (material, testimonial, occupational, plats, records, other monuments) used as a basis for accepting. If not accepted or if nothing was found, state evidence used as basis for establishing location. If reestablished through lost corner proportionate methods, indicate all monuments, distances and directions used to establish.

Notes of the original government survey indicate wood posts were set at all section and quarter-section corners. Stone monuments were subsequently placed at these corners during remonumentation surveys.


We found at road intersection a PK nail, but this corner was not on record. Proceeded to dig at road intersection with Lincoln County Backhoe and found 6"x6" Granite Stone 2 feet below the surface of road. Set 3/4" x 24" iron pipe on north side of stone. Corners falls on the centerline of C.T.H. "G" and 6.5 north of the centerline of Altenburger Drive.

**RECEIVED AT LINCOLN COUNTY
 COURTHOUSE THIS 1st DAY
 OF Feb. 2000
Pat Priebe
 LAND INFORMATION OFFICE**

(c) (d) (e) Plan view of corner with ties to at least 4 witness monuments. If in disagreement with previously established corner, show the distances between the two corners and also indicate the ties to the disputed corner.

- Set 7/8" x 30" iron rebar with Lincoln County cap.

rebar is 0.5' east of orange survey post

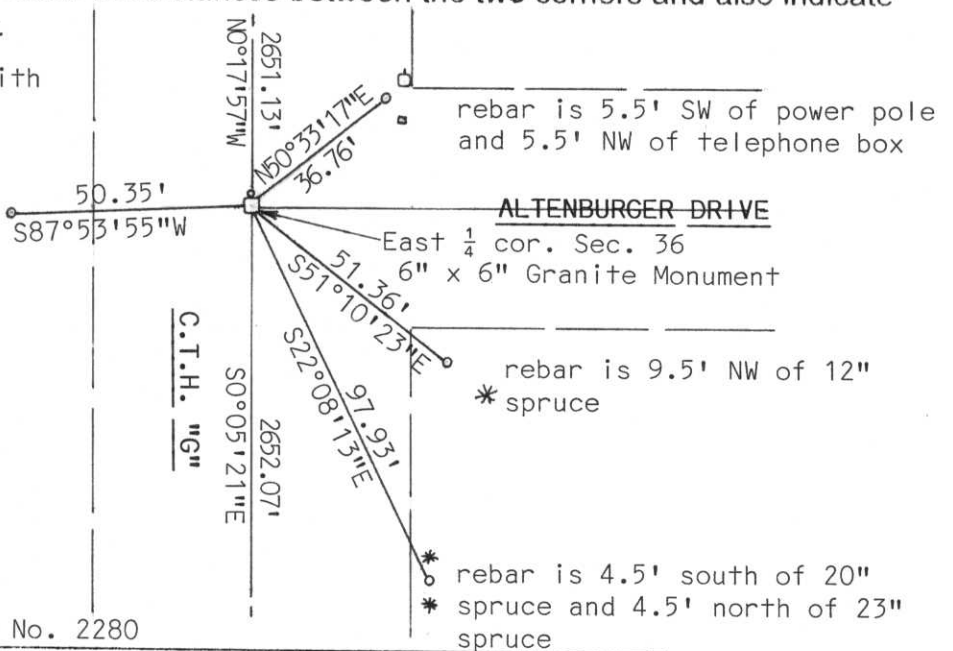

(i) I, David J. Goslin RLS No. 2280

(type or print name) certify that the corner location on this record was determined by me or under my direction and control and that this U.S. Public Land Survey Monument Record is correct and complete to the best of my knowledge and belief.

David J. Goslin

1-28-00

Signature

Date

Index No. W-25