

CERTIFIED LAND CORNER RESTORATION


Index No. 0-15

State of Wisconsin }
County of Lincoln } ss.

I Sheridan D. Schwark, do hereby certify that on the 13th day of October, 19 80, I found evidence of the North one-quarter corner of Section 34 Township 32, North, Range 8 East, Fourth, Principal Meridian, as described hereon; and that from this evidence I established a new monument and accessories as described hereon to perpetuate the original location of this corner.

Resident witnesses:

.....
.....
.....

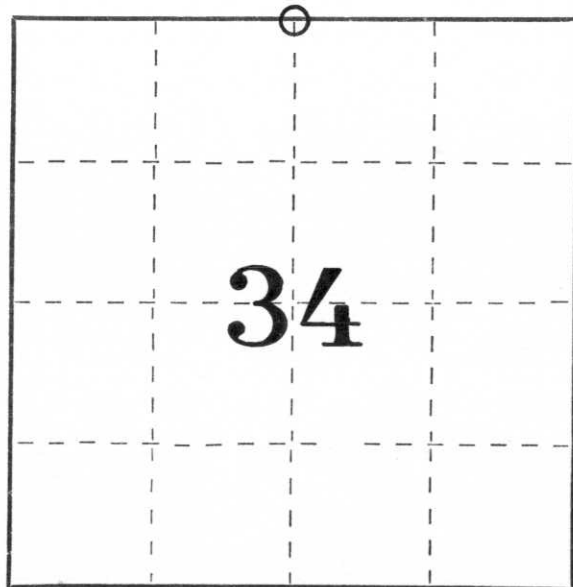

○ = Corner monument restored.


History of original corner establishment:

Wood post set by original government surveyor.

Description of corner evidence found:

We found a 6" x 6" granite monument up .8', we set the references shown below.

Description of monument and accessories I established to perpetuate the original location of this corner.

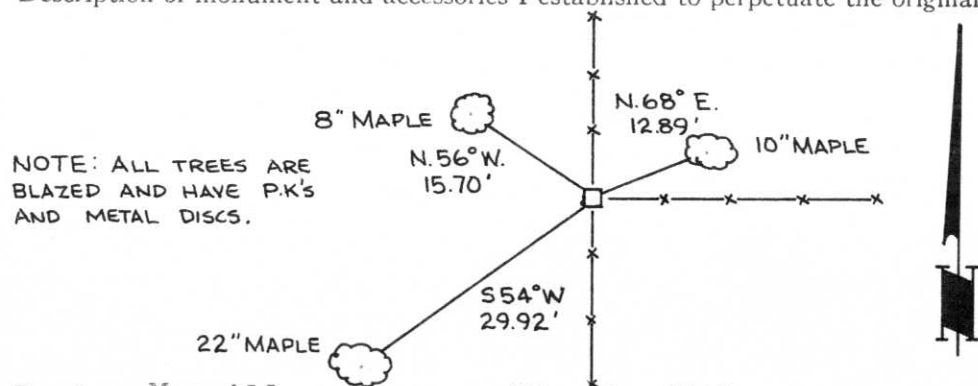

Dated at Merrill, Wis., this 24th day of October, 19 80.

Signature Sheridan D. Schwark Title Registered Land Surveyor Registration No. S-1205
(County Surveyor, Registered Land Surveyor, or other duly authorized official)

Office of Register of Deeds, County of _____, I hereby certify that the within instrument was filed in this office for record on the _____ day of _____, 19 _____ at _____ o'clock _____ M.

(Register of Deeds)

By _____ Deputy