

CERTIFIED LAND CORNER RESTORATION

Index No. W-13

State of Wisconsin }
County of LINCOLN } ss.

History of original corner establishment:



William F. Kelly 9-23-77

I WILLIAM F. KELLY do hereby certify that on the 23RD day of SEPTEMBER, 1977, I found evidence of the 1/4 SECTION corner of SECTION 33 & 34 Township 32, North, Range 8E, Fourth, Principal Meridian, as described hereon; and that from this evidence I established a new monument and accessories as described hereon to perpetuate the original location of this corner.

Description of corner evidence found:

LOCATED 6x6 GRANITE STONE SET IN 1920's. STONE IS 6" UNDER SURFACE OF A FARM ROAD AT END OF ROAD.



Resident witnesses:

.....
.....
.....

Description of monument and accessories I established to perpetuate the original location of this corner.

SET MONUMENT AS WITNESS CORNER AND PLACED IRON PIPES AT SIDE OF GRANITE.
MONUMENT MARKED:

MARKED NEW WITNESS TREES:

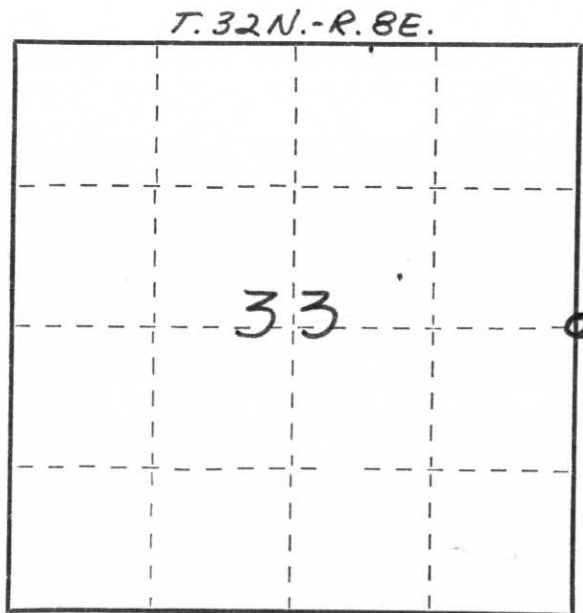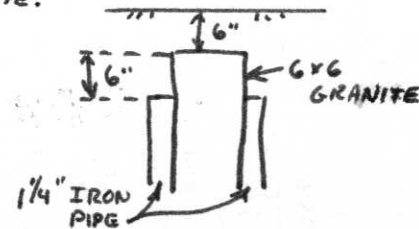

Dated at ELCHO, Wis., this 23RD day of SEPTEMBER, 1977

Signature William F. Kelly Title REGISTERED LAND SURVEYOR Registration No. 51098
(County Surveyor, Registered Land Surveyor, or other duly authorized official)

Office of Register of Deeds, County of _____, I hereby certify that the within instrument was filed in this office for record on the _____ day of _____, 19____ at _____ o'clock _____ M.

(Register of Deeds)

By _____ Deputy

○ = Corner monument restored.