

U S PUBLIC LAND SURVEY MONUMENT RECORD

NOTE: This form is intended and designed to fulfill all requirements of Wisconsin Administrative Code, Chapter A-E 7.08 U.S. Public Land Survey Monument Record (3) (a-i)

A-E 7.08(3)(a) Identity of corner:
SOUTHEAST CORNER SECTION 20,
TOWNSHIP 33 NORTH,
RANGE 05 EAST OF THE 4TH PM,
TOWN OF HARDING,
COUNTY OF LINCOLN

WISCRS - LINCOLN COUNTY
N: 174,678.942 USft (174,678.741)
E: 343,613.415 USft (343,612.982)
Datum: NAD83 (2011)
GNSS Method RTN - Direct
GNSS Control WISCORS VRS



The coordinate value shown has been verified by the average of two or more GPS observations at a markedly different time. Coordinates shown in parenthesis are provided by Lincoln County.

A-E 7.08(3)(b)

Original Surveyor: Jackson L. Prentice

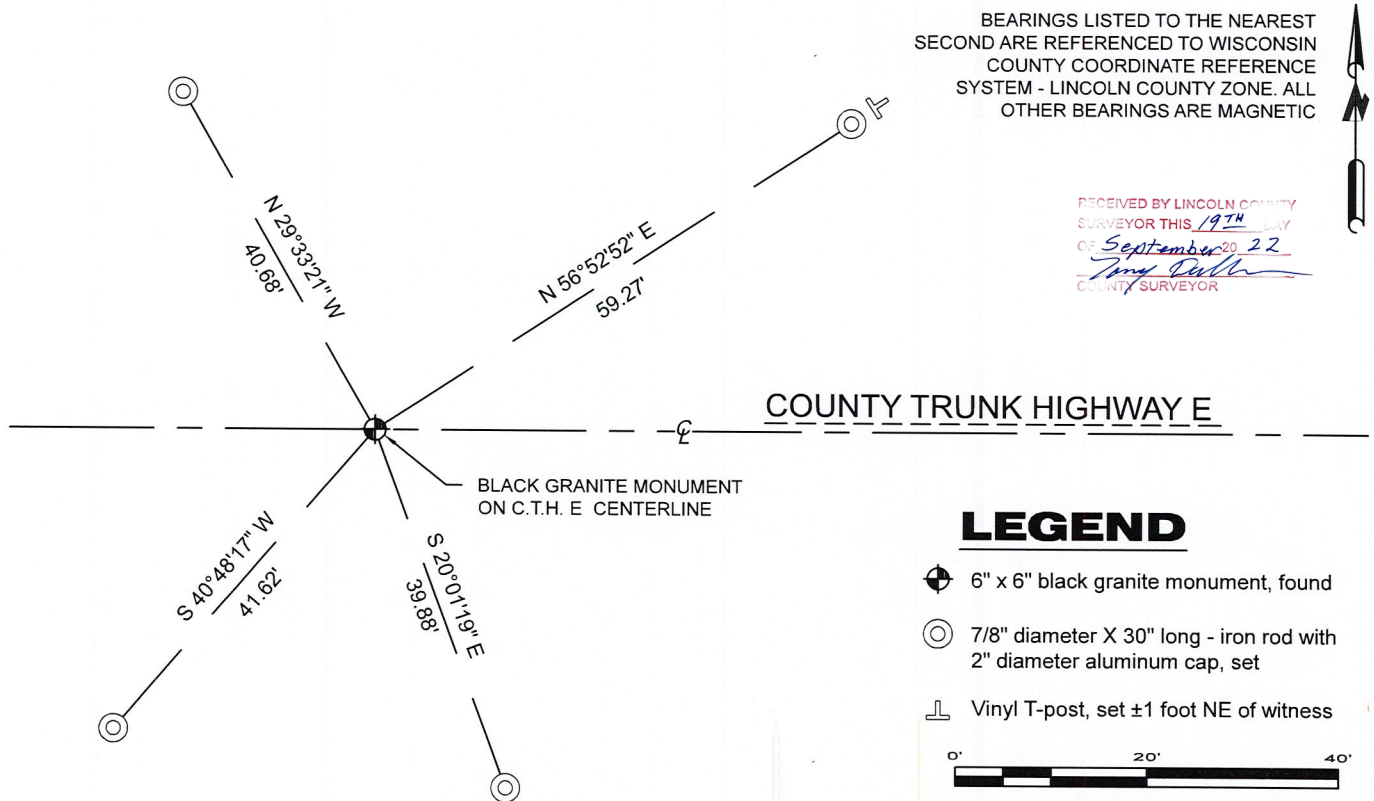
Date of Original Survey Commenced: November 9, 1854
Completed: November 21, 1854

Original Accessories:
Pine 12 N 41° E 16 Links
Tamarac 10 N 42° W 26 Links
Tamarac 12 S 26° W 16 Links
Tamarac 11 _____ 32 Links

January 26, 2010 - Surveyor 2729 - Gregory S. Maines - indicate this position as "N174678.74, E343612.98 provided by Lincoln County" on Lincoln County Section Summary - Section 28, T 33 N, R 5 E.

June 29, 2022 - While performing the 2022 Lincoln County PLSS Corner Remonumentation and GPS Services project, I found a 6" x 6" black granite monument near the computed position provided by Lincoln County. The monument is on the of C.T.H. E centerline, and ±14" below road grade. I established 4 new reference monuments as shown below.

A-E 7.08(3)(c)(d) Plan view of corner with references to at least 4 witness monuments.



A-E 7.08(3)(e) 1854 Surveyor set a post, 2010 Surveyor had coordinates. I found a granite stone.

A-E 7.08(3)(f) I accept this monument as a FOUND PERPETUATED LOCATION of the corner.

A-E 7.08(3)(g)(h) This corner was not determined through lost-corner-proportionate methods.

A-E 7.08(3)(i) I, Jeffrey L. DeMuth, Professional Land Surveyor No. S-2656, hereby certify that the corner location on this record was determined by the Lincoln County Surveyor, and the monuments found or set as shown hereon were measured by me or under my direction and control, and that this U.S. Public Land Survey Monument Record is correct and complete to the best of my knowledge, and belief.

SIGNATURE

September 16, 2022

DATE



REPORT

2022-Lincoln County PLSS Corner Remonumentation and GPS Services

Wisconsin Corner Point Identification Number: 43305200000

Surveyor: Jeffrey L. DeMuth – S2656

Corner monument: Found 6" x 6" black granite stone.

Field Book: Cardinal North – Lincoln Co. Remon. – 2022-00

Page: 35

Horizontal Datum: WisCRS – Lincoln County Zone – NAD83(2011)

Date / time of initial measurement:

June 29, 2022 - Start 11:32:32 CDT – End 11:36:34 CDT

Reference monuments:

4 – Set - 7/8" diameter X 30" long iron rods with 2" diameter Lincoln Co. aluminum cap.

Coordinate Table

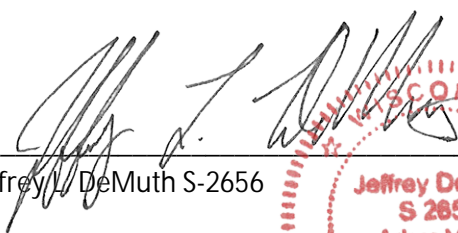
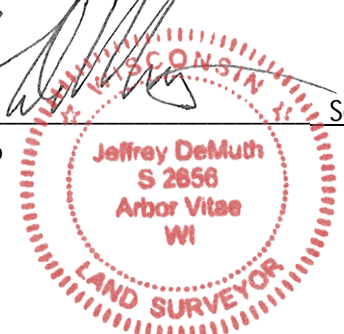
	County Provided	2022 Measurement	Difference
North	174678.741	174678.942	-0.20
East	343612.982	343613.415	-0.43

Observed coordinates match existing calculated coordinates within reason.

Request Data Log for more information.

Additional Notes:

Corner falls on the centerline of C.T.H. E. and $\pm 14"$ below road grade There is a woods road heading south from the corner.


Jeffrey L. DeMuth S-2656

September 16, 2022
Date

43305200000_Mon-N



4330520000_North



43305200000_West



4330520000_South



43305200000_East

