



PRESERVATION OF LANDMARKS

PAGE _____

SECTION 59,635(7) WISCONSIN STATUTES
 COUNTY LINCOLN
 TOWN ROCK FALLS
 HIGHWAY CTH "J"
 SECTION NO. 5 12 & 13
 T. 33 N., R. 6 E.
 TYPE OF LANDMARK 1/16 CORNER
 LOCATION INDICATED ON SKETCH X

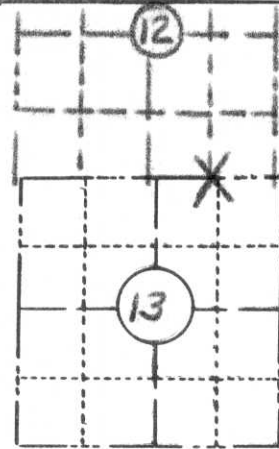

LOCATION SKETCH

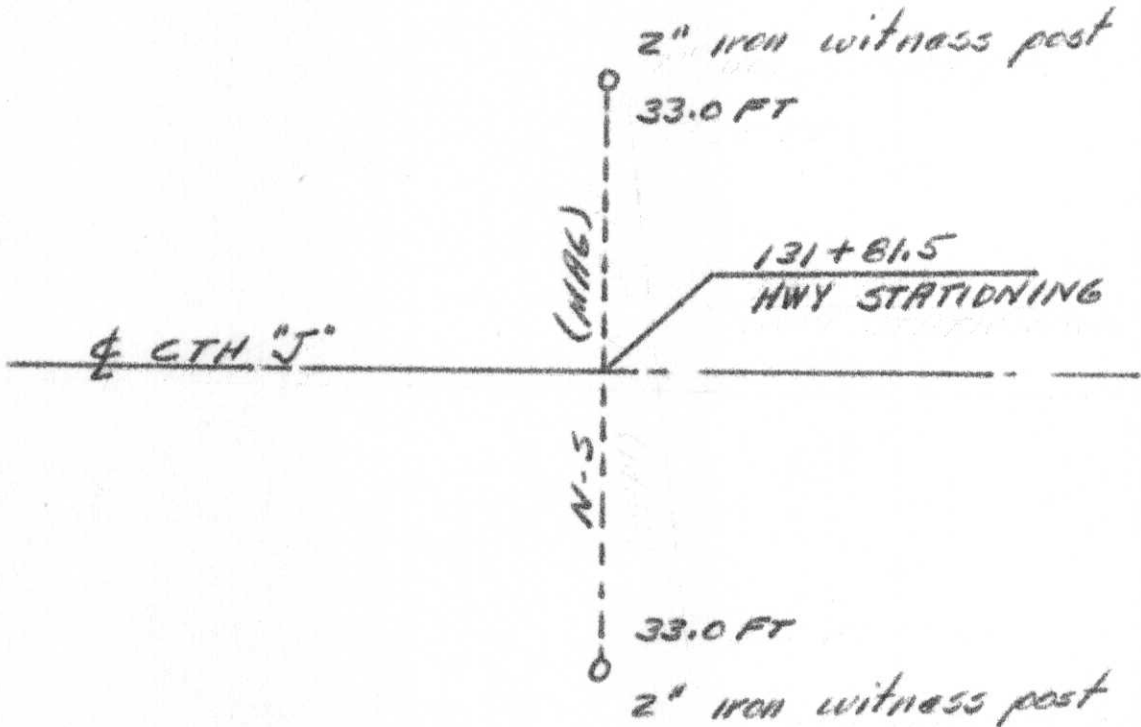

This space for copy of field notes or ties to the above described landmarks

Field notes or records filed in book no. Form 710 on file
 at the W.H.C. Dist. No. 7 office.
 City of Rhinelander, Oneida County.
 Located or established by PM Johnson, 1961
 Title Engineer II

County Clerk's Office _____ County, Wis. }^{ss}
 Received for record _____, 19____


Copy sent to County Surveyor _____, 19____

County Clerk

Index No. I-24

PRESERVATION OF LANDMARKS


SECTION 59,635(7) WISCONSIN STATUTES
 COUNTY LINCOLN
 TOWN ROCK FALLS
 HIGHWAY CTH "J"
 SECTION NO. 5 12 & 13
 T. 33 N., R. 6 E.
 TYPE OF LANDMARK 1/16 CORNER
 LOCATION INDICATED ON SKETCH X

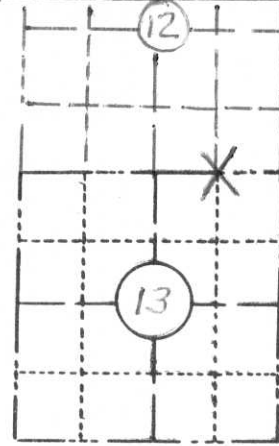

PAGE



LOCATION SKETCH

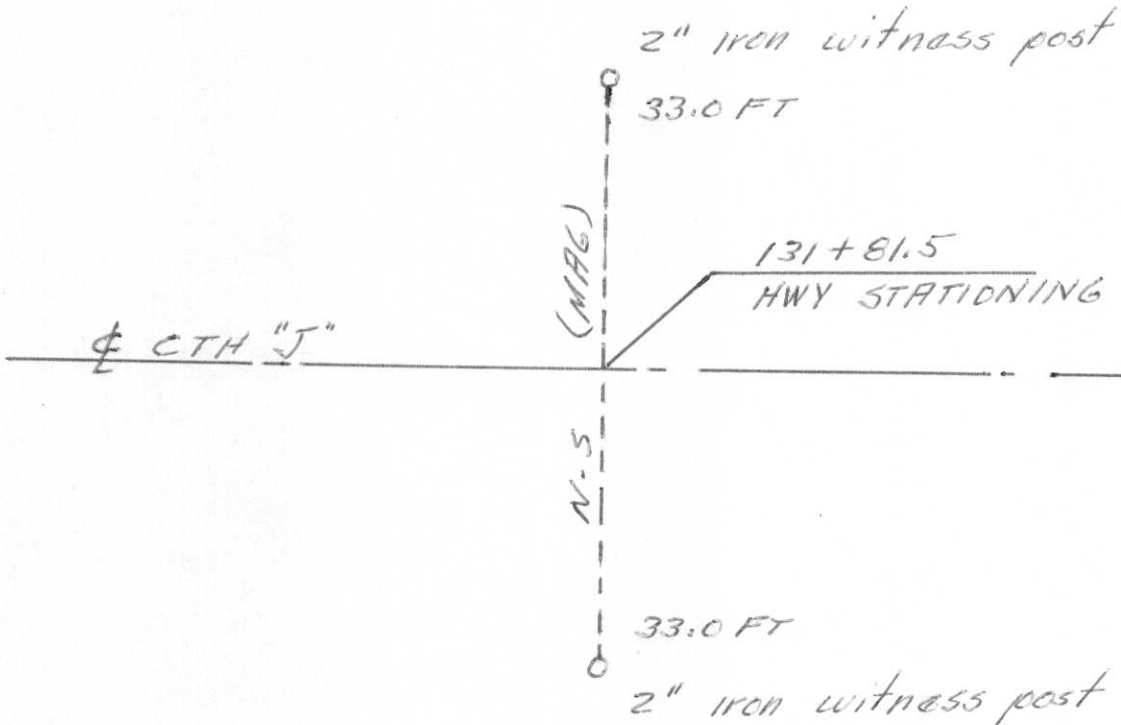

This space for copy of field notes or ties to the above described landmarks

Field notes or records filed in book no. Form 710 on file
 at the W.H.C., Dist. No. 7 office.
 City of Rhineland, Onaida County.
 Located or established by PM Johnson, 1961
 Title Engineer II

County Clerk's Office _____ County, Wis. } ss
 Received for record _____, 19____

Copy sent to County Surveyor _____, 19____


County Clerk

Index No.

I-24

PRESERVATION OF LANDMARKS


SECTION 59,635(7) WISCONSIN STATUTES
 COUNTY LINCOLN
 TOWN ROCK FALLS
 HIGHWAY CTH "J"
 SECTION NO.S 12 & 13
 T. 33 N., R. 6 E.
 TYPE OF LANDMARK 1/16 CORNER
 LOCATION INDICATED ON SKETCH X

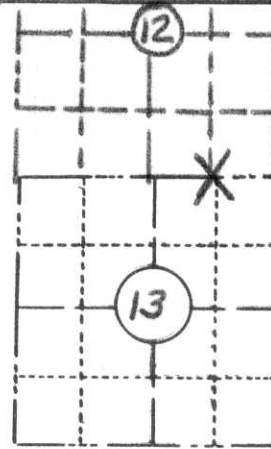

PAGE _____



LOCATION SKETCH

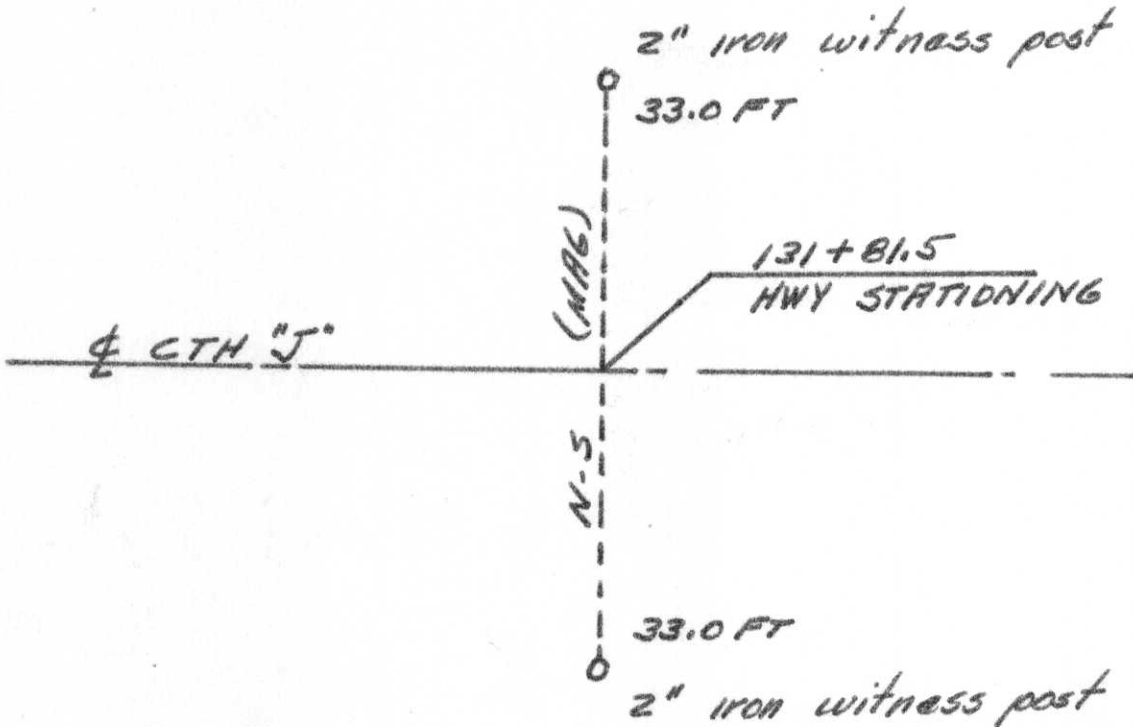

This space for copy of field notes or ties to the above described landmarks

Field notes or records filed in book no. Form 710 on file
 at the W.H.C., Dist. NO. 7 office.
 City of Rhinelander, Oneida County.
 Located or established by PM Johnson, 1961
 Title Engineer II

County Clerk's Office _____ County, Wis. } ss
 Received for record _____, 19____

Copy sent to County Surveyor _____, 19____

County Clerk

Index No. I - 24