


LINCOLN COUNTY U.S. PUBLIC LAND SURVEY MONUMENT LOCATION RECORD

CORNER NUMBER 143367
 SECTION 14
 TOWNSHIP 33 NORTH
 RANGE 6 EAST
 ROCK FALLS
 CITY, VILLAGE, TOWN

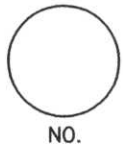

LANDMARK BENCHMARK
 FOUND SET
 RESET
 RE-TIED


CORNER IDENTITY: SOUTH 1/4 CORNER SECTION 14
 LINCOLN COUNTY COORDINATE: N: 179722.08
 E: 388605.01

ELEVATION—(FEET): _____ DATUM: _____

WEATHER: PARTLY CLOUDY

DATE OF SURVEY: 10-28-05 TEMPERATURE: 45 °F

SURVEY PARTY: NATHAN WINCENTSEN, KEITH WALKOWSKI

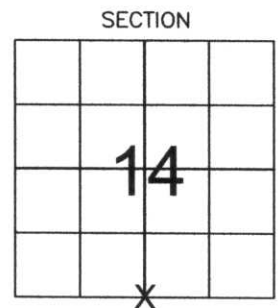

SECTION
 LOCATION
 (Indicated By X)



BASIS FOR MONUMENT LOCATION:

(DESCRIBE METHOD OF SURVEY AND CORNER AUTHENTICATION)

EXCAVATED FOR SOUTH 1/4 CORNER WITH COUNTY GRADALL, FOUND GRANITE STONE ±4' BELOW ROAD SURFACE TIPPED. RESET STONE AND SET 1" IRON PIPE ON NORTH SIDE OF STONE. ACCEPTED STONE AS CORNER LOCATION AND PERPETUATED CORNER AS SHOWN BELOW.



CERTIFIED CORRECT:
Keith J. Walkowski
 Registered Land Surveyor
 DATE: Nov. 27th, 2005

FIELD BOOK NO. 6 PAGE NO. 16
 COMPANY RIVERSIDE LAND SURVEYING LLC


TIE SKETCH:

SHOW MINIMUM OF FOUR (4) HORIZONTAL TIE DISTANCES TO FIXED WITNESS MONUMENTS. DESCRIBE ALL MONUMENTS FOUND OR SET. CORRECT ALL DISTANCES SHOWN TO STANDARD TEMPERATURE OF 68° F.

- FOUND GRANITE STONE
- SET 3/4" REBAR WITH ALUMINUM CAPS
- VINYL SURVEY MARKER POST

NOTE

- ALL BEARINGS ARE FROM A HAND HELD MAGNETIC COMPASS
- THIS DRAWING IS NOT TO SCALE

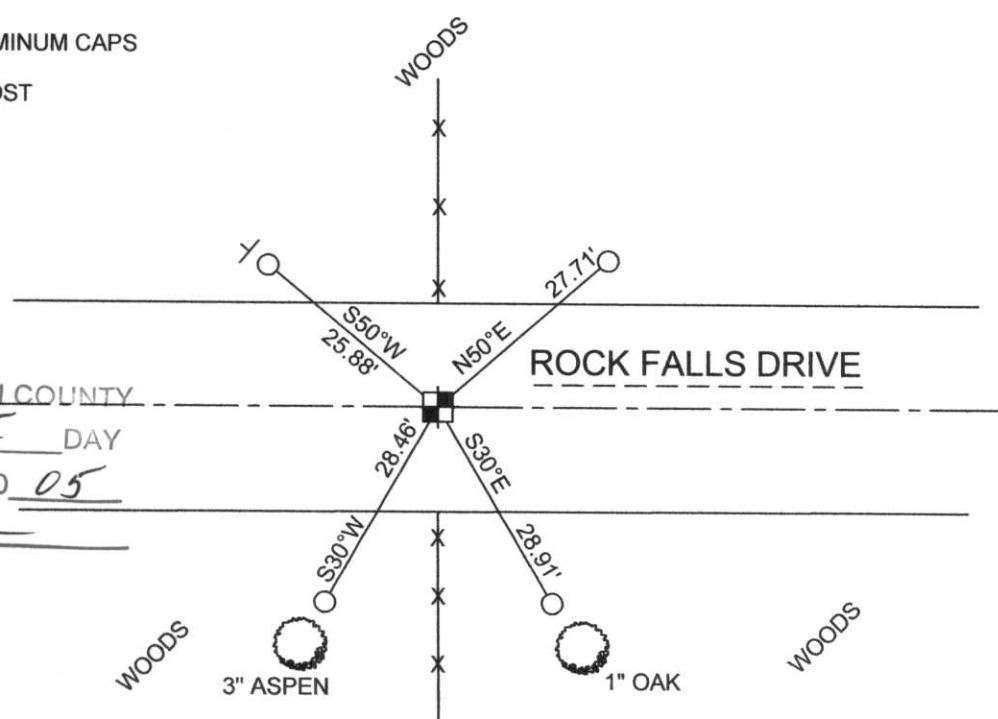

RECEIVED BY LINCOLN COUNTY SURVEYOR THIS 19th DAY OF December 20 05
Tony Dahl
 COUNTY SURVEYOR

M-19

