


U.S. PUBLIC LAND SURVEY MONUMENT RECORD

Note: This form is intended and designed to fulfill all requirements of Wisconsin Administrative Code, Chapter A-E 5.02, U.S. Public Land Survey Monument Record (3) (a) (b) (c) (d) (e) (f) (g) (h) (l). An additional sheet may be added if necessary to conform with said requirements.

(a) Corner location: Township 33 North
 Range 6 East
 Town/City/Village Rock Falls
 County Lincoln

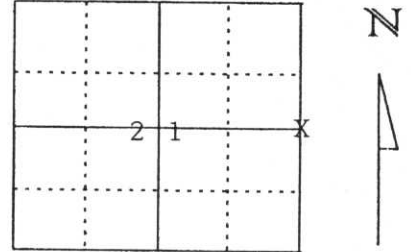


Section 21

(b) (f) (g) (h) Description of monument found at this corner and if it was accepted, state all evidence (material, testimonial, occupational, plats, records, other monuments) used as a basis for accepting. If not accepted or if nothing was found, state evidence used as basis for establishing location. If reestablished through lost corner proportionate methods, indicate all monuments, distances and directions used to establish.

Excavated the intersection of Eggert Drive and Woodenware Road, found a 1½" Iron Pipe 2 feet below surface approximately 33 feet South of a 1" Iron Pipe. A worker for the Town of Rock Falls said he had seen the stone marking the corner lying in a nearby ditch. A search turned up nothing. We accepted the position of this Iron Pipe as the corner. We replaced this Iron Pipe with a Lincoln County Berntsen Monument. Laid pipe along side. Tied to 7/8" rebar with Lincoln County caps.

(c) (d) (e) Plan view of corner with ties to at least 4 witness monuments. If in disagreement with previously established corner, show the distances between the two corners and also indicate the ties to the disputed corner.

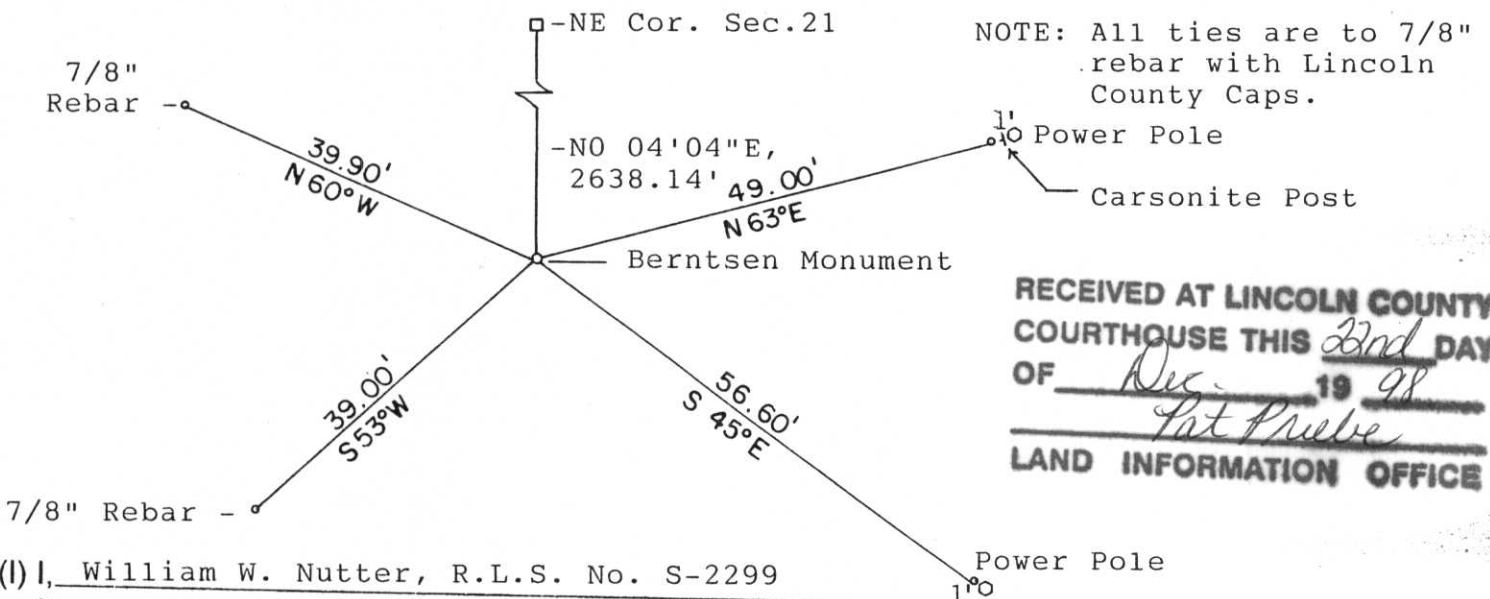

**RECEIVED AT LINCOLN COUNTY
 COURTHOUSE THIS 22nd DAY
 OF Dec. 19 98
Pat Pruebe
 LAND INFORMATION OFFICE**

(l) I, William W. Nutter, R.L.S. No. S-2299
 (type or print name) certify that the corner location on this record was determined by me or under my direction and control and that this U.S. Public Land Survey Monument Record is correct and complete to the best of my knowledge and belief.

William W. Nutter 12-21-98
 Signature Date

Index No. 0-13

