


U.S. PUBLIC LAND SURVEY MONUMENT RECORD

Note: This form is intended and designed to fulfill all requirements of Wisconsin Administrative Code, Chapter A-E 5.02, U.S. Public Land Survey Monument Record (3) (a) (b) (c) (d) (e) (f) (g) (h) (i). An additional sheet may be added if necessary to conform with said requirements.

(a) Corner location: Township 33 North
 Range 6 East
 Town/City/Village TN. OF ROCK FALLS
 County Lincoln

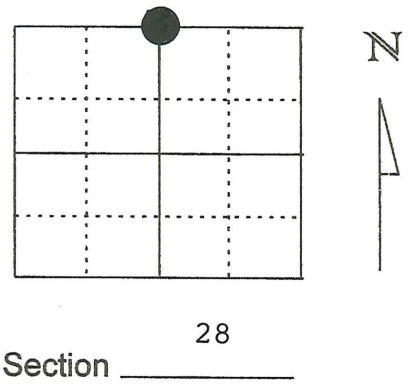


Section 28

(b) (f) (g) (h) Description of monument found at this corner and if it was accepted, state all evidence (material, testimonial, occupational, plats, records, other monuments) used as a basis for accepting. If not accepted or if nothing was found, state evidence used as basis for establishing location. If reestablished through lost corner proportionate methods, indicate all monuments, distances and directions used to establish.

FOUND 4"X4" BLACK GRANITE STONE WITH AN IRON BAR ON NORTH SIDE OF STONE SET BY FRANCIS FOX IN 1941. NO EVIDENCE OF WITNESS PIPES FOR CORNER POSITION. USED FOX'S NOTES TO GET CLOSE AND EXCAVATED THE ROAD. STONE WAS 18" BELOW ROAD SURFACE.

RECEIVED AT LINCOLN COUNTY
 COURTHOUSE THIS 14TH DAY
 OF December 20 00
Jerry Dallman
 LAND INFORMATION OFFICE

(c) (d) (e) Plan view of corner with ties to at least 4 witness monuments. If in disagreement with previously established corner, show the distances between the two corners and also indicate the ties to the disputed corner.

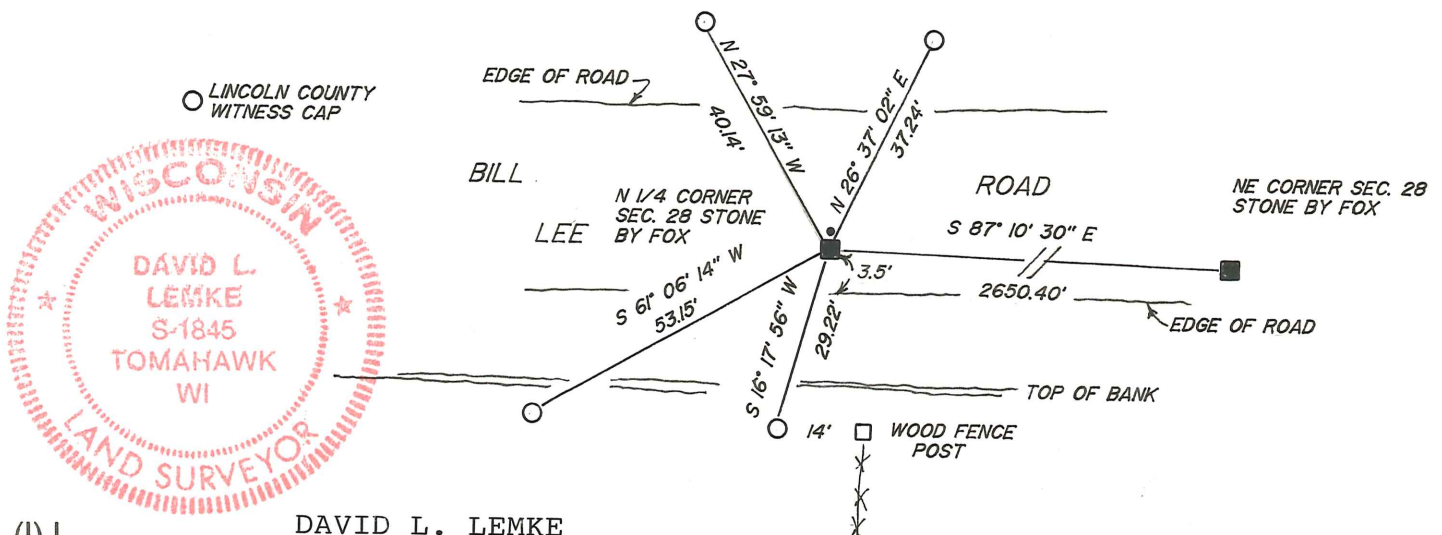

(I) I, DAVID L. LEMKE
 (type or print name) certify that the corner location on this record was determined by me or under my direction and control and that this U.S. Public Land Survey Monument Record is correct and complete to the best of my knowledge and belief.
David L. Lemke
 Signature _____ Date DEC. 13 2000

Index No. Q-11