



2002 10 16



2002 10 16



2002 10 16



2002 10 16

INDEX (cont)


| | Page |
|--------------------------------------|------|
| 59.) N.W. Cor. Sec. 8-33-7E | 59. |
| 60.) E. 1/4 Cor. Sec. 6-33-7E | 60. |
| 61.) Center Sec. 6-33-7E | 61. |
| 62.) W. 1/4 Cor. Sec. 6-33-6 1/2 7E | 62. |
| 63.) N.E. Cor. Sec. 6-33-7E | 63. |
| 64.) N. 1/4 Cor. Sec. 6-33-7E | 64. |
| 65.) N.W. Cor. Sec. 6-33-6 1/2 7E | 65. |
| 66.) E. 1/4 Cor. Sec. 31-34-7E | 66. |
| 67.) Center Sec. 31-34-7E | 67. |
| 68.) W. 1/4 Cor. Sec. 31-34-6 1/2 7E | 68. |
| 69.) N.E. Cor. Sec. 31-34-7E | 69. |
| 70.) N. 1/4 Cor. Sec. 31-34-7E | 70. |
| 71.) N.W. Cor. Sec. 31-34-6 1/2 7E | 71. |
| 72.) E. 1/4 Cor. Sec. 30-34-7E | 72. |
| 73.) Center Sec. 30-34-7E | 73. |
| 74.) W. 1/4 Cor. Sec. 30-34-6 1/2 7E | 74. |
| 75.) N.E. Cor. Sec. 30-34-7E | 75. |
| 76.) N. 1/4 Cor. Sec. 30-34-7E | 76. |
| 77.) N.W. Cor. Sec. 30-34-6 1/2 7E | 77. |
| 78.) E. 1/4 Cor. Sec. 19-34-7E | 78. |
| 79.) Center Sec. 19-34-7E | 79. |
| 80.) W. 1/4 Cor. Sec. 19-34-6 1/2 7E | 80. |
| 81.) N. 1/4 Cor. Sec. 19-34-7E | 81. |
| 82.) N.W. Cor. Sec. 19-34-6 1/2 7E | 82. |
| 83.) N. 1/4 Cor. Sec. 24-34-6E | 83. |
| 84.) N.W. Cor. Sec. 24-34-6E | 84. |

76.

T 33 N

R 6 E

May 4, 1971

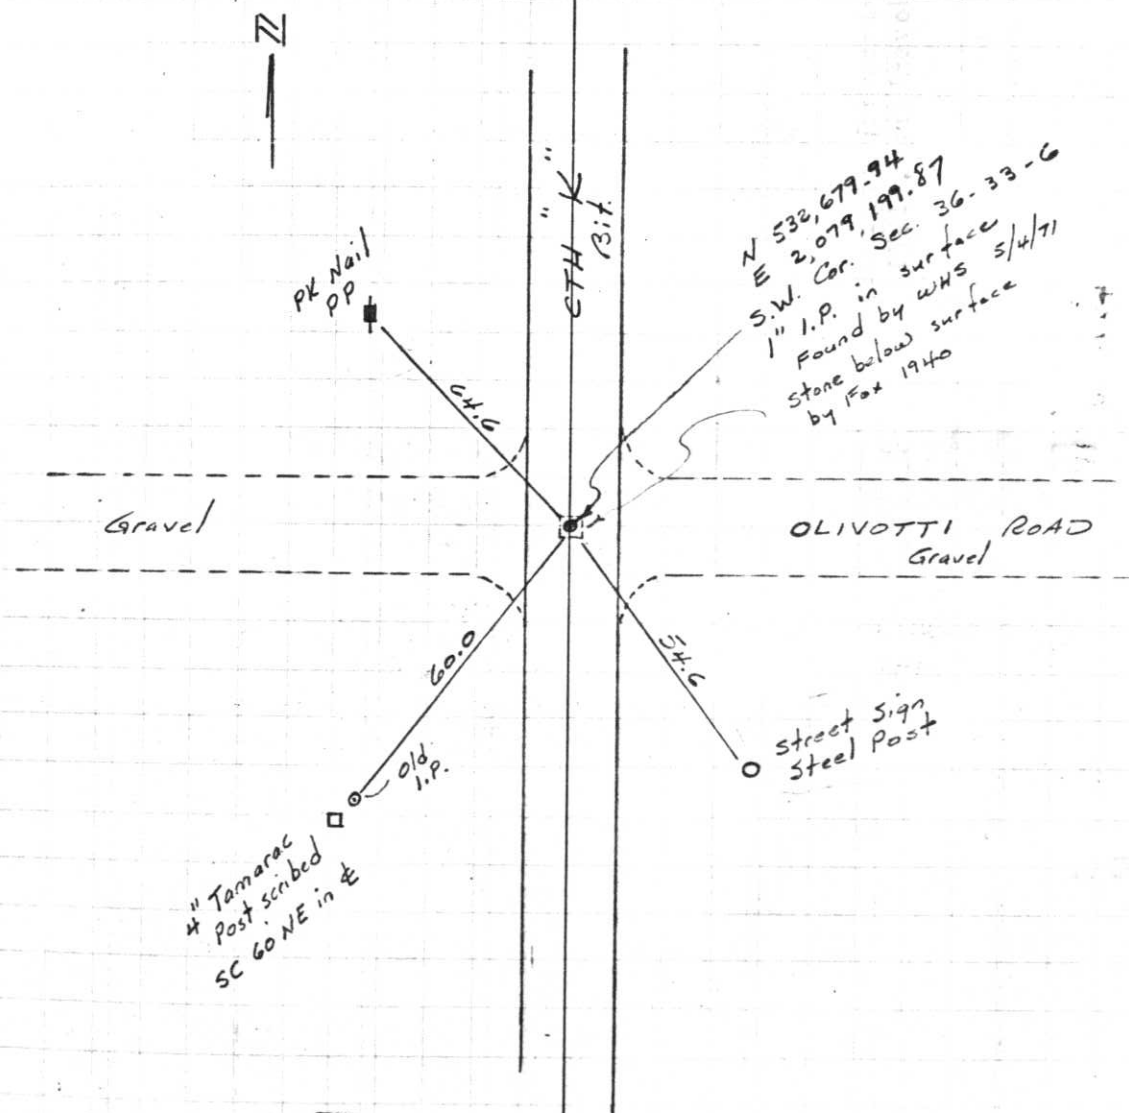

Project I.D. 1173-5-00 1.4 Mi. N.
 Merrill-C.T.H. "s" U.S.H. 51
 Freeway Lincoln County Wm. Scherer
 Surveyor Received from Division of
 Hwy's. Jan. 11. 1973