


State of Wisconsin }  
County of Langlade } ss.

I, Raymond J. Hallisy, do hereby certify that on the 20th day of July, 1968, I found evidence of the S 1/16 corner of Section 6 Township 33, North, Range 9, Fourth Principal Meridian, as described hereon; and that from this evidence I established a new monument and accessories as described hereon to perpetuate the original location of this corner.

Resident witnesses:

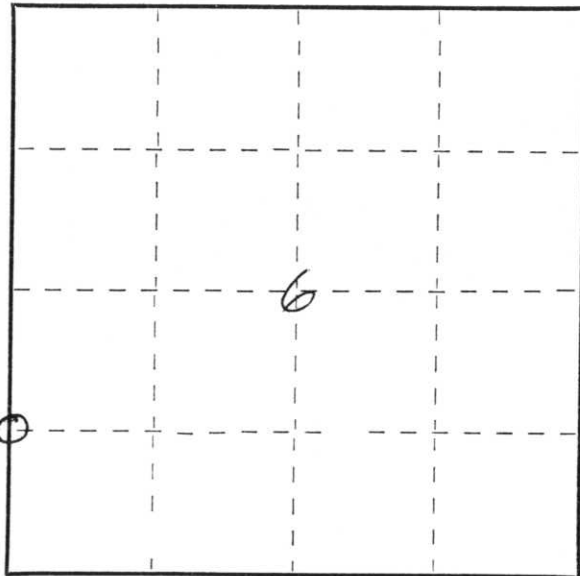

○ = Corner monument restored.

# CERTIFIED LAND CORNER RESTORATION

History of original corner establishment:


Corner set in the 1930's

*S 1/16 Sec 1-33-8*

Description of corner evidence found:

Found wood stake standing, 2" iron pipe on E side  
Marked W 50 LKS to Cor. S1/16 S1 S6

Description of monument and accessories I established to perpetuate the original location of this corner.  
Set Std. pipe with cap marked W. C. 50 LKS W to Cor. S1/16 S1 S6

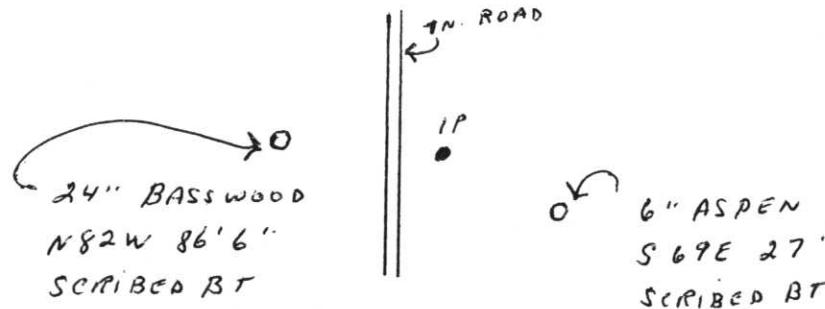

Dated at Antigo, Wis., this 20th day of July, 1968.

Signature Raymond J. Hallisy Title Reg. Land Surveyor Registration No. S-685  
(County Surveyor, Registered Land Surveyor, or other duly authorized official)

Office of Register of Deeds, County of \_\_\_\_\_, I hereby certify that the within instrument was filed in this office for record on the \_\_\_\_\_ day of \_\_\_\_\_, 19\_\_\_\_ at \_\_\_\_\_ o'clock \_\_\_\_\_ M.

(Register of Deeds)

By \_\_\_\_\_ Deputy

33-9 V-20  
Index No. D-1

RECEIVED AT LINCOLN COUNTY  
COURTHOUSE THIS DAY  
OF \_\_\_\_\_