


CERTIFIED LAND CORNER RESTORATION

Index No. I-9

State of Wisconsin }
County of Lincoln } ss.

I Sheridan D. Schwark, do hereby certify that on the 18th day of June, 1976, I found evidence of the Southeast section corner of Section 8 Township 34, North, Range 5 East, Fourth, Principal Meridian, as described hereon; and that from this evidence I established a new monument and accessories as described hereon to perpetuate the original location of this corner.

Resident witnesses:
.....
.....
.....

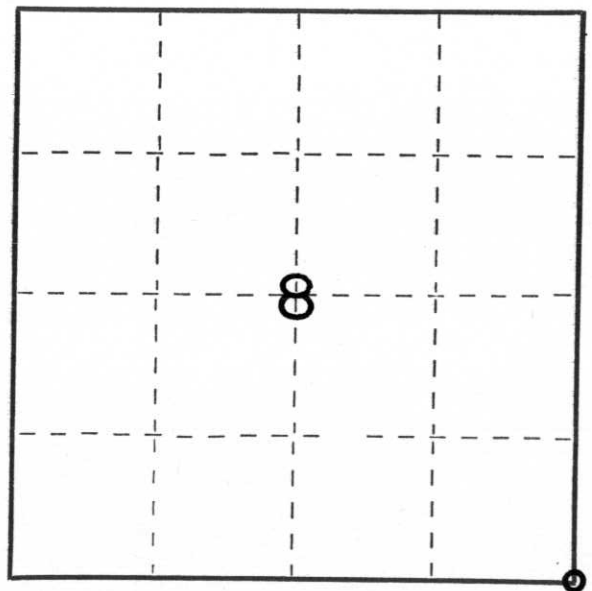

○ = Corner monument restored.

History of original corner establishment:
Original Surveyor - Jackson L. Prentice - January, 1855
Witnesses: 11" Pine, S33°E, 4 lks.
10" Pine, S75°W, 25 lks.
9" Pine, S39°W, 35 lks.
10" Pine, N25°E, 28 lks.

Description of corner evidence found:
Found 1" iron pipe set by James G. Griffin, R.L.S. S-755, February 13, 1969 -
Witnesses: Road sign post, S51°W, 28.2 feet
Stop sign, S34°E, 33.0 feet
7" Birch, S46°E, 88.0 feet

Description of monument and accessories I established to perpetuate the original location of this corner.

Set aluminum 30" Lincoln County Bernsten Monument -
Witnesses: 3/4" iron rod, N32°E, 82.5 feet
3/4" iron rod, N50°W, 76.8 feet
P.K. nail in Power Pole No. 743, S48°W, 52.8 feet
P.K. nail in 9" White Birch, S53°E, 88.0 feet

Dated at Merrill, Wis., this 6th day of July, 1976

Signature Sheridan D. Schwark Title Registered Land Surveyor Registration No. 1205
(County Surveyor, Registered Land Surveyor, or other duly authorized official)

Office of Register of Deeds, County of....., I hereby certify that the within instrument was filed in this office for record on the..... day of....., 19..... at..... o'clock..... M.

.....
(Register of Deeds)

By..... Deputy





