

U.S. PUBL	IC LAND SUR	VEY MONUMENT	RECORD
Note: This form is intended and Public Land Survey Monu conform with said require	d designed to fulfill all require ument Record (3) (a) (b) (c) (e ements.	ements of Wisconsin Administrative d) (e) (f) (g) (h) (i). An additional shee	
(a) Corner location: Town	iship <u>34</u> North		
	e5_East		
TownTomahawk			
CountyLincoln			
EV 100 (1 11 11 12 12 12 12 12 12 12 12 12 12 1			Section 11
not accepted or if not	ning was found, state lost corner proportions	this corner and if it was accords, other monuments) used a evidence used as basis for ate methods, indicate all mo	s a basis for accepting. If
		nd here. A lack of section	,
from those corners to survey distances for between the length	this corner, as set those lines. The	double proportioning. It double proportioning. It east were of some assistant, were uniformly proportionly discrepancy resulting the south quarter corner	onal to the distances onal to the original on the disparity
established corner, show disputed corner.	or with ties to at least 4 w w the distances betwe	witness monuments. If in disagent the two corners and also	reement with previously indicate the ties to the
	C.T.H. '0'		
N		SW Corner Section 11-34-5 Berntsen Monument 1.5' Centerline, 1" below blo	
		Witness Monuments (Mo	onetic Reorings)
		Power Pole S22°E 34.7	
_		Roofing Nail in blaze o 11.5" Red Pine S54*W 7	וח
		10.0" Dak N60°W 77.5'	5.30
		7.1" Dak N53*E 61.65' 9.5" White Pine S45*E	56.72′



Signature Date

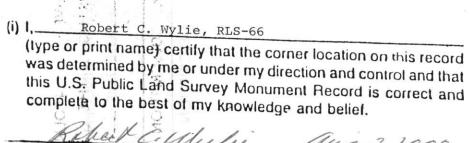

Index No. 2

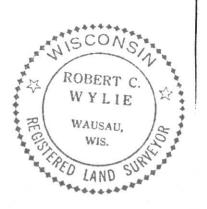



