

CERTIFIED LAND CORNER RESTORATION


Index No. I-21

State of Wisconsin }
County of Lincoln } ss.

I Lester J. Schmit, do hereby certify that on the 5th day of August, 1980, I found evidence of the Southeast corner of Section 11 Township 34, North, Range 5 East, Fourth, Principal Meridian, as described hereon; and that from this evidence I established a new monument and accessories as described hereon to perpetuate the original location of this corner.

Resident witnesses:

.....
.....
.....

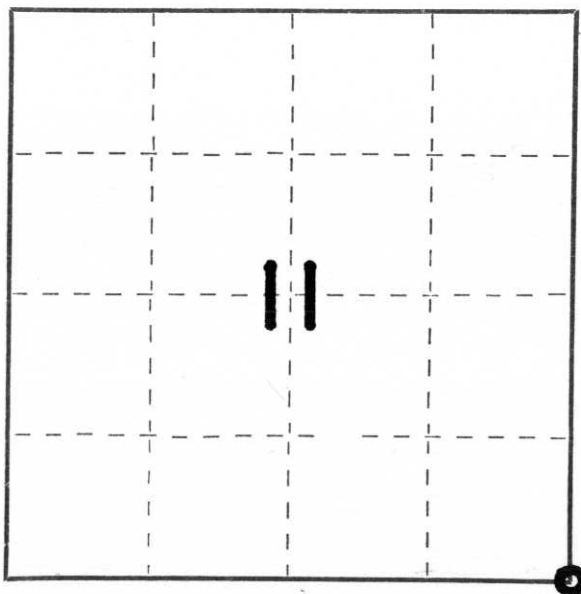

○ = Corner monument restored.

History of original corner establishment:

Surveyor: Jackson Prentice
Date: January 1855
Monumentation: Wood Post
Witnesses: Tamarack 7", N 50° W, 8 links
Tamarack 5", N 34° E, 20 links
Tamarack 8", S 40° E, 21 links
Tamarack 6", S 10° W, 11 links

Description of corner evidence found:

Found a 2½" x 2½" x 24" iron bar for section corner, 2.0' south of centreline of County Trunk Highway "0". Section corner is witnessed by a 1½" iron pipe, South, 31.35'.

Description of monument and accessories I established to perpetuate the original location of this corner.

Set a 30" Berntsen aluminum monument for the Section corner, with the iron bar along side and to the east.

Witnesses: P.K. nail in 8" White Pine, N 52° W, 103.85'
P.K. nail in Power Pole # 3405 11R1, N 12° E, 34.64'
1" iron pipe, N 01° E, 33.36'

Dated at Tomahawk, Wis., this 29th day of October, 1980.

Signature Lester J. Schmit Title Land Surveyor Registration No. S 1192
(County Surveyor, Registered Land Surveyor, or other duly authorized official)

Office of Register of Deeds, County of....., I hereby certify that the within instrument was filed in this office for record on the.....day of....., 19..... at.....o'clock..... M..

.....
(Register of Deeds)

By.....Deputy





