

REPORT

2022-Lincoln County PLSS Corner Remonumentation and GPS Services

Wisconsin Corner Point Identification Number: 43405242000

Surveyor: Jeffrey L. DeMuth – S2656

Corner monument: Found 7/8" diameter X 30" long iron rod – top 12" bent to the north. I removed and replaced in kind.

Field Book: Cardinal North – Lincoln Co. Remon. – 2022-00

Page: 27

Horizontal Datum: WisCRS – Lincoln County Zone – NAD83(2011)

Date / time of initial measurement:

June 2, 2022 - Start 12:38:54 CDT – End 12:47:59 CDT

Reference monuments:

3 – Set - 7/8" diameter X 30" long iron rods with 2" diameter Lincoln Co. aluminum cap.

1 – Found – 7/8" diameter iron rods with 2" diameter Lincoln Co. aluminum cap.

Coordinate Table

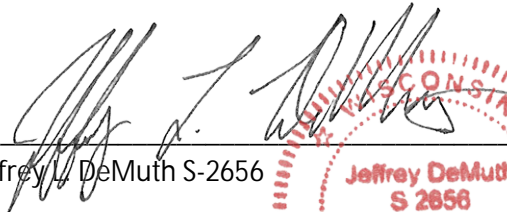
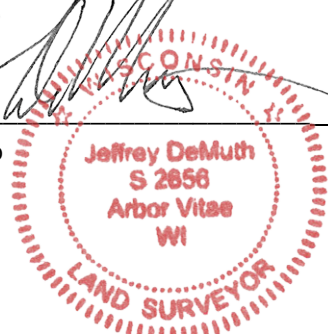
	County Provided	2022 Measurement	Difference
North	208885.599	208885.617	-0.02
East	364963.893	364963.684	0.21

Observed coordinates match existing calculated coordinates within reason.

Request Data Log for more information.

Additional Notes:

Corner falls ±1 feet east of Swamp Road centerline, and ±8" below road grade. There is a cut line heading east from the corner.


 Jeffrey L. DeMuth S-2656
 
 September 16, 2022
 Date

43405242000_Mon-N



43405242000_North



43405242000_West



43405242000_South



43405242000_East

