


HINK CAPITAL SURVEYING, INC.
SURVEY MONUMENT LOCATION RECORD

LANDMARK BENCHMARK
 CORNER IDENTITY N 1/16 COR ON WEST SECTION
 DATE OF SURVEY Oct 23, 1974
 WEATHER CALM CLEAR
 TEMPERATURE 45°±
 SURVEY PARTY D. TUSTY D. MATTINGLY

FOUND
 SET
 RE-SET
 RE-TIED


SECTION 16
 TOWNSHIP 34
 RANGE 8E
HARRISON
 (CITY/VILLAGE/TOWN)
LINCOLN.

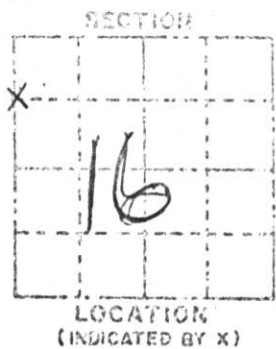

BASIS FOR MONUMENT LOCATION
 DESCRIBE METHOD OF SURVEY AND CORNER AUTHENTICATION

SEE SURVEY FOR PAT BUCKETT
 OF SW-NW

TIE SKETCH SHOW HORIZONTAL TIE DISTANCES TO FIXED WITNESS MONUMENTS. DESCRIBE ALL MONUMENTS FOUND OR SET

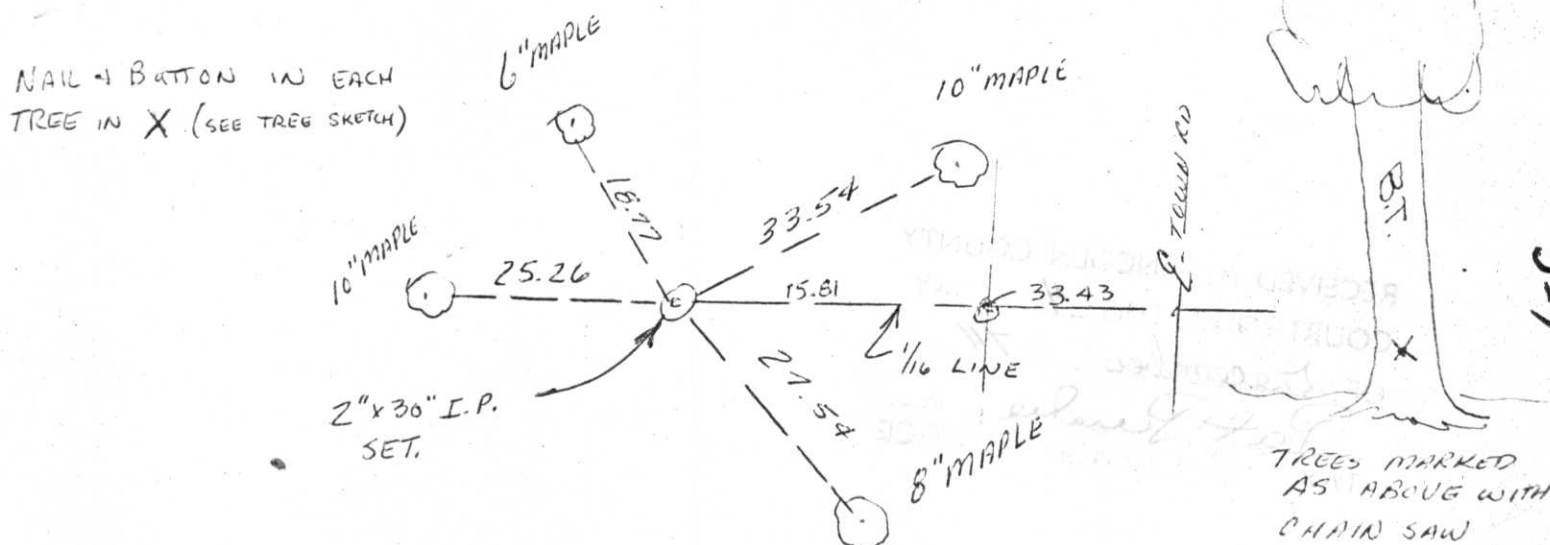

16-34-8E