

U.S. PUBLIC LAND SURVEY MONUMENT RECORD


NOTE: This form is intended and designed to fulfill all requirements of Wisconsin Administrative Code, Chapter A-E 7 .08 U.S. Public Land Survey Monument Record (3)(a)(b)(c)(d)(e)(f)(g)(h)(i). An additional sheet may be added if necessary to conform with said requirements.

(a) Corner location: Township 34 North

Range 8 East

Town of Harrison

County of Lincoln

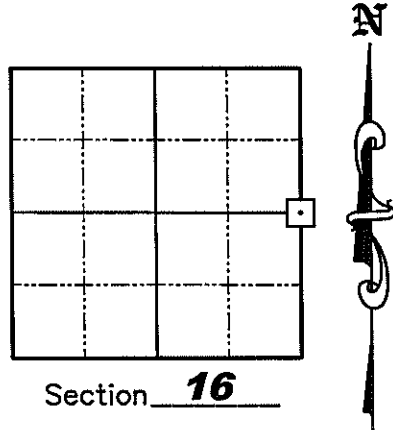

(b)(f)(g)(h) Description of monument found at this corner and if it was accepted, state all evidence (material, testimonial, occupation, plats, records, other monuments) used as a basis for accepting. If not accepted or if nothing was found, state evidence used as a basis for establishing location. If reestablished through lost corner proportionate methods, indicate all monuments, distances and directions used to establish. Indicate type of monument found or set and sign post.

1854 – Prentice Jackson set one-quarter post on North bank of lake;
Bearing trees: 18” Pine N10°W, 90 lks; 14” Pine N21°E 80 lks.

1938 – Francis Fox ran South between Section 15 and 16 2634.5 to an old 1/4 post in lake West of random 0.2’. He set stone in inlet between Bass Lake and Long Lakes; Pine stub N26°E, 53.6’


June 2007 – Jonathan W. Dulin found and accepted a 6” by 6” Granite Stone lying in the channel between Long Lake and Bass Lake. We referenced the corner as shown on Sheet 2 Hereof.

(c)(d)(e) Plan view of corner with ties to at least 4 witness monuments. If in disagreement with previously established corner, show the distances between the two corners and also indicate the ties to the disputed corner.

See Sheet 2 Hereof

(i) I, Jonathan W. Dulin, certify that the corner location on this record was determined by me under my direction and control and that this U.S. Public Land Survey Monument is correct and complete to the best of my knowledge and belief.

[Handwritten Signature]
Signature

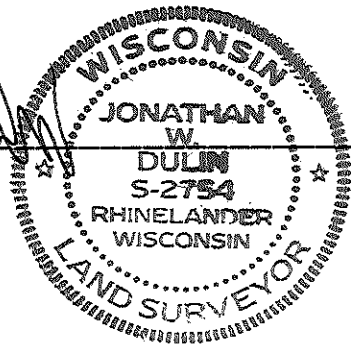

10-11-2007
Date

RECEIVED BY LINCOLN COUNTY
SURVEYOR THIS 28TH DAY
OF October 20 08
[Handwritten Signature]
COUNTY SURVEYOR

K-15

U.S. PUBLIC LAND SURVEY MONUMENT RECORD

(c)(d)(e) Plan view of corner with ties to at least 4 witness monuments. If in disagreement with previously established corner, show the distances between the two corners and also indicate the ties to the disputed corner.

