


Wis. Highway Dept - Box 162-163 Rhineland - Ripon corner  
 @ E 1/4 corner

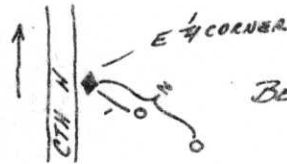

BEARING 523°24'E ? Further confirmation  
 needed - I believe bearing should  
 be Complementary Angle of 566°36'E  
 to correspond with 1937 Resurvey  
 DIST ON REFERENCE COR  
 1 36.85 FT  
 2 63.88 FT

COMMENCING AT E 1/4 CORNER USING 2° E DEC  
 COMMENCE TRANSIT RANDOM LINE AT 587° 45' W  
 LENGTH OF RANDOM 86.785 CHAINS FELL 94 LINKS  
 NORTH OF CORNER  
 CORRECTION 1.08 LINKS SOUTH/CHAIN TO TRUE  
 LINE

BEARING OF TRUE LINE 587° 7' 15" W

CORRECTED LINE EAST TO WEST

5 LKS	EAST EDGE OF CTH "N" (BLACKTOP)
1.0 CHAINS	EAST WEST EDGE OF FIELD
11.50 "	WEST " " "
20.00 "	SET SQUARE POST (21.60 LKS SO. OF RANDOM) THIS "IS NOT" A CORNER - ONLY MARKS LINE
40.00 "	SET SQUARE POST (43.20 LINKS SO. OF RANDOM) THIS "IS NOT" A CORNER - ONLY MARKS LINE BT ELM 8" N 40°15' W 37 LKS ELM 10" N 52° W 88 LKS
60.00 "	SET SQUARE POST (64.80 LINKS) SO. OF RANDOM THIS "IS NOT" A CORNER - ONLY MARKS LINE BT ASPEN 12" N 57° W 17.5 LKS
80.00 "	PICKET ON LINE 86.40 LINKS SO OF RANDOM
86.74 "	W 1/4 CORNER.

POSTS AT 20.00, 40.00 AND 60.00 ARE NOT CORNERS. THEY ONLY  
 MARK LINE AND DISTANCE FROM E 1/4 CORNER.

CERTIFIED LAND CORNER RESTORATION

34-4 W-25  
Index No. ....


State of Wisconsin }  
County of: LANGLADE } ss.

I RAYMOND J. HALLISY, do hereby certify that on the 13-14 day of APRIL, 1966, I found evidence of the E 1/4 AND W 1/4 corners of 31 Township 34 N, North, Range 9E, Fourth Principal Meridian, as described hereon; and that from this evidence I established a new monument and accessories as described hereon to perpetuate the original location of this corner.

Resident witnesses:

JERRY KEYKA - W.C.D. - ANTIGO  
STAN BANASH - W.C.D. - ANTIGO

C36-34-8  
T 34 N R 9 E

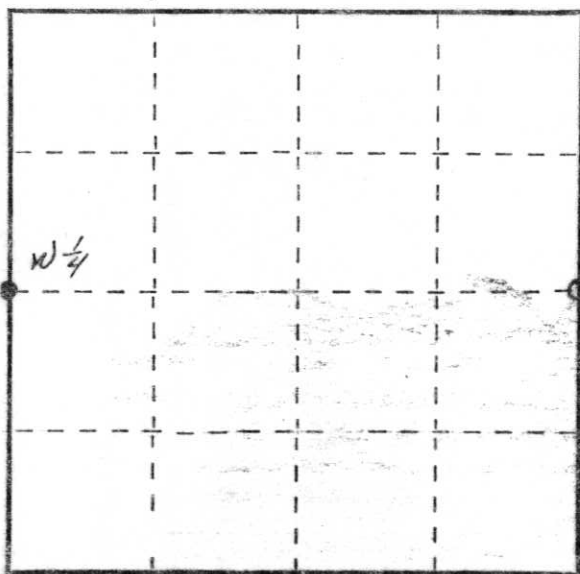

○ = Corner monument restored

History of original corner establishment:

LOCATED W 1/4 - BRASS CAP - RESURVEY OF 1937 BY T.H. KILROE AND DA. HINTE

LOCATED AND RESET E 1/4 - BRASS CAP - HISTORY - RESURVEY BY T.H. KILROE AND D. A. HINTE IN 1937 AND BOOK 162-163 OF STATE HWY COM - RHINELANDER, WISC. THE LATTER INFORMATION DESCRIBES CORNERS AND WORK IN RELOCATION OF CTH "H."

Description of corner evidence found:

BRASS CAPS FOR E 1/4 AND W 1/4  
○ E 1/4 RESET  
● W 1/4 LOCATED

Description of monument and accessories I established to perpetuate the original location of this corner.

TRANSIT SURVEY - CHAINS - PINS - AXES  
(SEE BACK)

RESET E 1/4 - CHAIN BETWEEN NE SEC. COR. AND SW. SEC. CORNER. DISTANCE 99.36 CHAINS CORRES PONDING TO 1937 RESURVEY. LOCATE 2 REFERENCE CORNERS (DATA FROM ABOVE BOOK) AND RESET E 1/4 COR. ON EAST SIDE OF CTH H

Dated at ANTIGO, Wis., this 3 day of MAY, 1966.

Signature Raymond J. Hallisy Title Asst. Dist. Forester and Reg. Wisc. Land Surveyor Registration No. 5-685  
(County Surveyor, Registered Land Surveyor, or other duly authorized official)

Office of Register of Deeds, County of \_\_\_\_\_, I hereby certify that the within instrument was filed in this office for record on the \_\_\_\_\_ day of \_\_\_\_\_, 19\_\_\_\_ at \_\_\_\_\_ o'clock \_\_\_\_\_ M.

(Register of Deeds)

By \_\_\_\_\_ Deputy

OVER

FORM 985 H. C. MILLER CO., MILWAUKEE

36-34-8  
E 1/4