


CERTIFIED LAND CORNER RESTORATION

Index No. C-13

State of Wisconsin }
County of Lincoln } ss.

I, Robert H. Winat, do hereby certify that on the 6th day of June, 1973, I found evidence of the East 1/4 corner of Section 4 Township 35, North, Range 4 East, Fourth, Principal Meridian, as described hereon; and that from this evidence I established a new monument and accessories as described hereon to perpetuate the original location of this corner.

Resident witnesses:

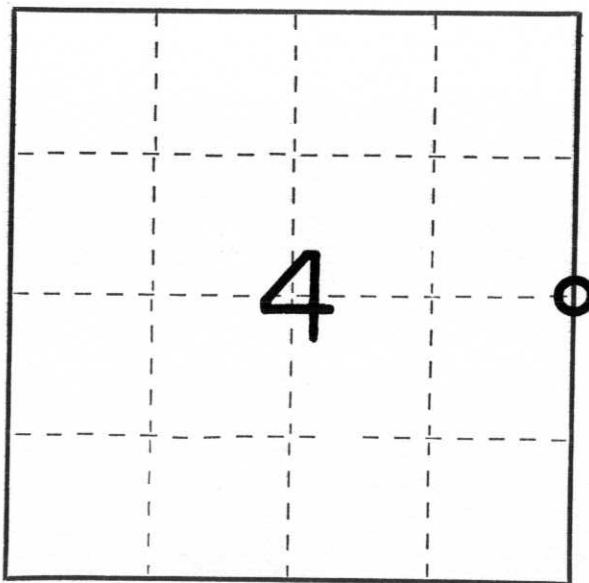

○ = Corner monument restored.

History of original corner establishment:

Edward Palmer
April 29, 1865
Wood post
6" Fir N45°W 17 lk
8" Cedar S80°E, 18 lk

Description of corner evidence found:

This corner was re-established by proportioning D.S. Burnett's 1923 re-survey information, since the iron pipe was found laying in the area of the old abandoned town road at the old east-west fence line in the general area of the re-established corner, but no further ties as to the specific location were found. Thus, the proportioned location was used.

Description of monument and accessories I established to perpetuate the original location of this corner.

Lincoln Co. Berntsen monument 36"
I.P. witness corner N18°-27'W 72.01' from 1/4 corner
9" Aspen S60°E, 58.03'
3" Balsam N25°E, 52.82'
4" Spruce S 6°W, 78.47'

Dated at Minocqua, Wis., this 10th day of November, 1974.

Signature Robert H. Winat Title land surveyor Registration No. S-1040
(County Surveyor, Registered Land Surveyor, or other duly authorized official)

Office of Register of Deeds, County of _____, I hereby certify that the within instrument was filed in this office for record on the _____ day of _____, 19____ at _____ o'clock _____ M.

(Register of Deeds)

By _____ Deputy