

CERTIFIED LAND CORNER RESTORATION


Index No. C-17

State of Wisconsin }
County of Lincoln } ss.

I Robert H. Winat, do hereby certify that on the 17 Jan. 73 & 16 day of November, 1974, I found evidence of the East 1/4 corner of Section 3 Township 35, North, Range 4 East, Fourth, Principal Meridian, as described hereon; and that from this evidence I established a new monument and accessories as described hereon to perpetuate the original location of this corner.

Resident witnesses:

.....
.....
.....

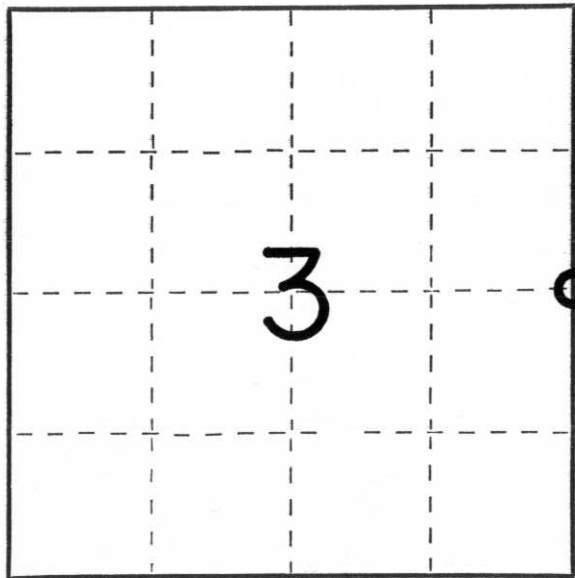

○ = Corner monument restored.

History of original corner establishment:

Surveyor: Edward Palmer
Date: April 27, 1865
Monumentation: Wood Post
Witnesses: 8" Hemlock N51°W, 27 lks
6" Hemlock S22°E, 15 lks

Description of corner evidence found:

2" iron pipe with 5" plate top - D.S. Burnett's 1923 re-survey - at intersection of fences north and west.
4" Hard Maple clump at Burnett's H. Maple 12" S82°E, 51 lks.
No other witness evidence apparent - area burned over?
Burnett states he had remains of original bearing trees.

Description of ~~monument and~~ accessories I established to perpetuate the original location of this corner.

Set post adjacent to iron pipe (in good condition)
PK Nail in 4" Maple S57°E, 13.50'
PK Nail in 7" H. Maple N21°W, 8.59'
PK Nail in 5" H. Maple N64°E, 27.65'
PK Nail in 7" Balsam N30°E, 50.35'

Dated at Minosqua, Wis., this 19th day of November, 1974.

Signature Robert H. Winat Title Land Surveyor Registration No. 51090
(County Surveyor, Registered Land Surveyor, or other duly authorized official)

Office of Register of Deeds, County of....., I hereby certify that the within instrument was filed in this office for record on the..... day of....., 19..... at..... o'clock..... M..

.....
(Register of Deeds)

By..... Deputy