


U.S. PUBLIC LAND SURVEY MONUMENT RECORD

Note: This form is intended and designed to fulfill all requirements of Wisconsin Administrative Code, Chapter A-E 7.08 U.S. Public Land Survey Monument Record (3)(a)(b)(c)(d)(e)(f)(g)(h)(i). An additional sheet may be added if necessary to conform with said requirements.

(a) Corner location: Township 35 North
 Range 05 (East) West

Town/City/Village WILSON
 County LINCOLN

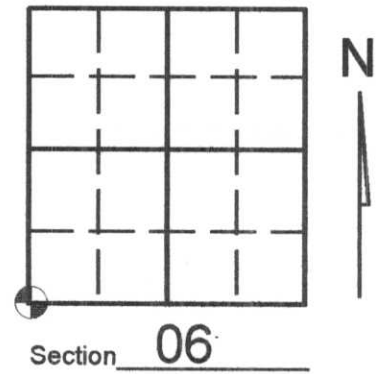

(b) (f) (g) (h) Description of monument found at this corner and if it was accepted, state all evidence (material, testimonial, occupational, plats, records, other monuments) used as a basis for accepting. If not accepted or if nothing was found, state evidence used as basis for establishing location. If reestablished through lost corner proportionate methods, indicate all monuments, distances and directions used to establish. Indicate type of monument found or set and sign post.

August 1860 - Sept 1860: Alfred Millard set post and made the following B.T.'S:
 12" Hemlock N80°W, 21 Links
 10" Fir N50°E, 15 Links
 6" Y. Birch, S48°E, 25 Links
 6" Sugar, S48°W, 51 Links

Sept. 1923: Burnett set corner and marked new B.T.'S:
 12" Hemlock S24°E, 60 Links
 10" H. Maple N28°E, 20.5 Links

May 2007: Kevin Bixby found 2" iron pipe along side a wood post and witnessed as shown below.

(c) (d) (e) Plan view of corner with ties to at least 4 witness monuments. If in disagreement with previously established corner, show the distances between the two corners and also indicate the ties to the disputed corner.

SCALE: 1"=30'

RECEIVED BY LINCOLN COUNTY
 SURVEYOR THIS 30TH DAY
 OF May 20 07
Kevin Bixby
 COUNTY SURVEYOR



NOTE: Distances measured to bend point in 2" iron pipe as said pipe is deflected to southwest. White plastic sign post is +/- 1.00' south of 2" iron pipe and wood post.

LEGEND

- 1- = EXISTING 2" IRON PIPE
- 2-, -3-, -4-, -5- = LINCOLN COUNTY CAPPED IRON ROD WITNESS MONUMENT

(i) I, KEVIN P. BIXBY

(type or print name) certify that the corner location on this record was determined by me or under my direction and control and that this U.S. Public Land Survey Monument Record is correct and complete to the best of my knowledge and belief.

Kevin P. Bixby Signature 05/23/07 Date



Stamp

Index No. _____

E-1