

RECORD CODES:
 FB-FIELD BOOK
 L -LARGE MAP
 S -SMALL MAP
 V -VERTICAL FILE
 SD-SECTION DRAWING
 CS-CERTIFIED SURVEY
 P -RECORDED PLAT

6	5	4	3	2	1
7	8	9	10	11	12
18	17	16	15	14	13
19	20	21	22	23	24
30	29	28	27	26	25
31	32	33	34	35	36


T 35 N, R 4 E

NO. _____

U.S. PUBLIC LAND SURVEY MONUMENT RECORD

CHECK IF INFO ON BACK _____

1. THE COMMON CORNER OF SECTIONS 9/10/15/16, T 35 N, R 4 E.
 2. ORIGINAL GOVERNMENT SURVEYOR- EDWARD PALMER, DATE- APRIL 1865
 3. ORIGINAL BEARING TREES - FEET - SUBSEQUENT RECOVERY RECORD
 4. FIR 6 N45W 33 LKS - 21.8 -D.S. BURNETT FOUND STAKE & ORIG
 5. FIR 7 N37E 24 LKS - 15.8 -HEMLOCK PER PAGE 6 OF HIS FIELD
 6. FIR 6 S60E 19 LKS - 12.5 -NOTES DATED SEPT 14, 1923.
 7. HEMLOCK 10 S18W 35 LKS - 23.1 -
 8. ORIGINAL TOPOGRAPHY CALLS - FEET - PRESENT TOPOGRAPHY
 9. ENTER CEDAR SWAMP N 5.00 CHS - 330 - NOT CHECKED
 10. CHS - -
 11. SUBSEQUENT RECORDS IN COUNTY SURVEYOR OFFICE WHICH REFER TO THIS CORNER
 12. D.S.BURNETT FIELDBOOK -PAGE 6. GENISOT & ASSOC MAP OF SECTION 9.
 - 13.
 14. SUBSEQUENT MONUMENTS OF RECORD -SURVEYOR- DATE- RECORD NO.
 15. FOUND IRON PIPE - GENISOT- ? -MAP OF SEC 9
 - 16.
 17. SUBSEQUENT BT'S OR WM'S - FEET -SURVEYOR- DATE- RECORD NO.
 18. S. MAPLE 9 S62-20E 38 LKS - 25.1 -BURNETT -1923 - PAGE 6 OF FB
 19. BIRCH 20 S22-15W 34 LKS - 22.4 -BURNETT -1923 - PAGE 6 OF FB
 20. B. ASH 12 N31-00W 36 LKS - 23.8 -BURNETT -1923 - PAGE 6 OF FB
 21. ADJOINING CORNER - MY DISTANCE -RECORD FT -SURVEYOR- DATE- RECORD NO.
 22. 1/4 CORNER NORTH - 2580.87 - 2583.47 - BURNETT- 1923- PAGE 6 OF FB
 23. 1/4 CORNER NORTH - 2580.87 - 2582.58 - GENISOT- ? - MAP OF SEC 9
 24. 1/4 CORNER EAST - 2554.14 - 2553.21 - BURNETT- 1923- PAGE 7 OF FB
 25. OTHER INFO IN RECORDS- PER HIS FB, BURNETT WAS SETTING IRON MONUMENTS AT
 26. OTHER CORNERS IN THIS AREA, BUT HE FAILED TO MENTION SETTING AN IRON
 27. MONUMENT HERE.
 28. EVIDENCE FOUND AT CORNER- 2" IRON PIPE WITH 5" SQUARE PLATE CAP, PROJECTING
 29. 24". 6" x 7' CEDAR POST DOWN WITH REMNANTS OF OLD WHITE AND BLUE PAINT.
 30. EAST EDGE OF RECENT CLEAR CUT, OLDER CLEARCUT TO SOUTHEAST. STANDING
 31. TIMBER TO NORTHEAST QUADRANT. NO EVIDENCE OF BURNETT BT'S.
 32. PERSONS WHO SAW EVIDENCE- AL AND JEFF SCHNEIDER
 33. OTHER REASONS FOR LOCATING CORNER HERE -
 - 34.
 - 35.
 36. PRESENT CORNER MONUMENT-
 37. PIPE, LINE 28. SET IRON FENCE POST 1' SOUTH.
 38. PRESENT WITNESS MONUMENTS-
 39. 3/4" X 30" SOLID ROUND IRON BARS.
 40. GENERAL AREA DESCRIPTION-
 41. 300'+- SOUTH OF PRIVATE ROAD, NEAR
 42. SW CORNER OF STANDING TIMBER.
 43. LINCOLN CO. COORDS. 97 HARN
 44. N 248379.52 E 317717.98
 45. MAG N = 0 DEGREES AZ
- DRAWN BY: J. SCHNEIDER
- = THIS CORNER
 - ⊗ = IRON WITNESS MONUMENT
 - = OTHER REFERENCE - TREES
- MEASURED TO ALUMINUM NAIL IN SIDE TO COINCIDE WITH CENTER AT ROOT CROWN, AND WITH YELLOW PLASTIC SIGNS FACING CORNER.

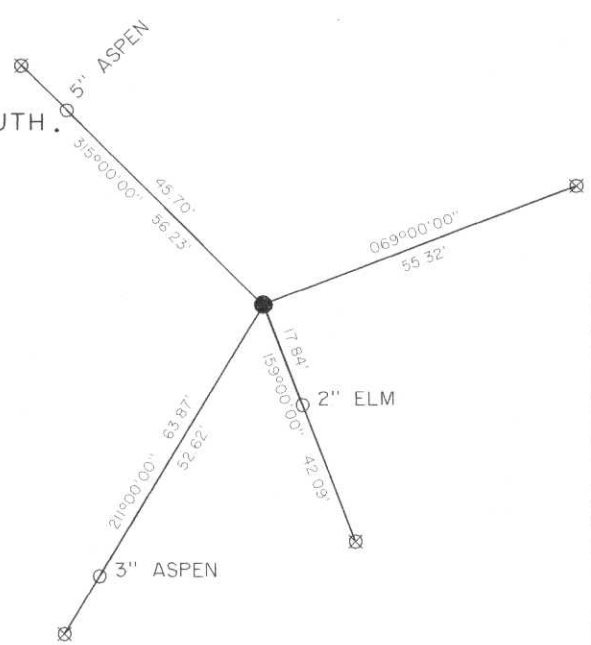

SEQUENCE NO. : N3440-E0330



I CERTIFY THAT ON THE 9TH DAY OF APRIL, 2001,
 I PERPETUATED THIS CORNER AS SHOWN, DATED THIS
10 DAY OF May 2001.
Al Schneider, LAND SURVEYOR