


CERTIFIED LAND CORNER RESTORATION

Index No. I-11
549

State of Wisconsin }
County of Lincoln } ss.

I Lester J. Schmit, do hereby certify that on the 25th day of July, 1975, I found evidence of the North 1/4 corner of Section 16 Township 35, North, Range 5 East, Fourth, Principal Meridian, as described hereon; and that from this evidence I established a new monument and accessories as described hereon to perpetuate the original location of this corner.

Resident witnesses:

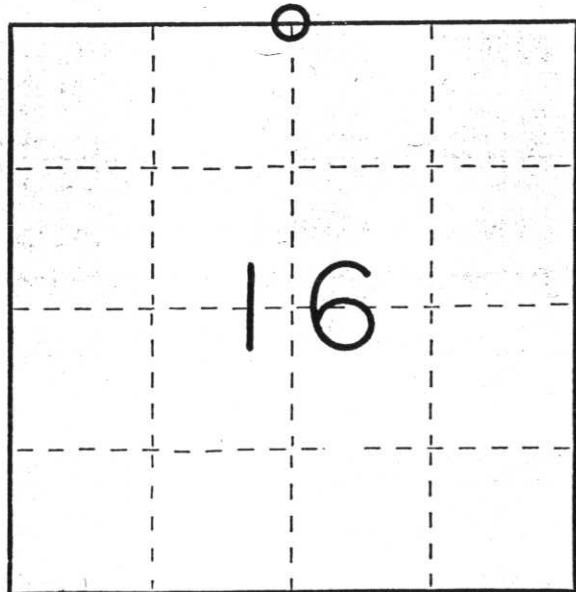

○ = Corner monument restored.

History of original corner establishment:
Surveyor:: Joseph W. Jenkins
Date: October 1862
Monumentation:: Wood Post
Witnesses: 12 Maple, S 42° W, 30 lks.
10 Elm, N 66° W, 36 lks.

FD WOOD POST
LYING ON GROUND

Description of corner evidence found: Found a 2" iron pipe referenced to on Northwoods Surveyors map # 7-16-355. The corner is near the intersection of centre-lines of old vacated roads to the north & east.

FD BERTSEN (FLUSH)
FD 2"x2" IRON (FLUSH)

NO RECORD? OF BERTSEN MON.
RECEIVED AT LINCOLN COUNTY
COURTHOUSE THIS 24TH DAY
OF July 20 01

Tony Dalton
LAND INFORMATION OFFICE

Description of monument and accessories I established to perpetuate the original location of this corner.

Berntsen Monument - 30" (Set flush with the surface.)

P.K. Nail in 8" Maple, N 38° E, 18.54' 18.60' BM 19.45' TO IRON
P.K. Nail in 13" Maple, S 55° E, 51.36' 51.40' BM 50.15' TO IRON
P.K. Nail in 11" Maple, S 55° W, 13.49' 13.43 to nail to BM 13.49 TO IRON
P.K. Nail in 8" Maple, N 35° W, 54.70' 54.67 BM 56.15' TO IRON

Dated at Tomahawk, Wis., this 31st day of August, 1978.

Signature Lester J. Schmit Title Land Surveyor Registration No. S-1192
(County Surveyor, Registered Land Surveyor, or other duly authorized official)

Office of Register of Deeds, County of _____, I hereby certify that the within instrument was filed in this office for record on the _____ day of _____, 19____ at _____ o'clock _____ M.

(Register of Deeds)

By _____ Deputy

CERTIFIED LAND CORNER RESTORATION


Index No. I-11

State of Wisconsin }
County of Lincoln } ss.

I Lester J. Schmit, do hereby
certify that on the 25th day
of July, 19 75, I found
evidence of the North 1/4
corner of Section 16
Township 35, North, Range
5 East, Fourth, Principal Meridian,
as described hereon; and that from this evidence
I established a new monument and accessories
as described hereon to perpetuate the original
location of this corner.

Resident witnesses:

.....
.....
.....

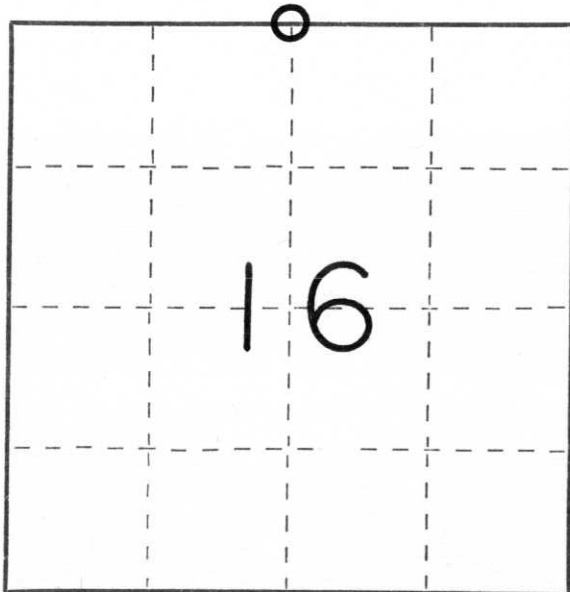

○ = Corner monument restored.

History of original corner establishment:

Surveyor: Joseph W. Jenkins
Date: October 1862
Monumentation: Wood Post
Witnesses: 12 Maple, S 42° W, 30 lks.
10 Elm, N 66° W, 36 lks.

Description of corner evidence found: Found a 2" iron pipe referenced to on Northwoods Surveyors map # 7-16-355. The corner is near the intersection of centre-lines of old vacated roads to the north & east.

Description of monument and accessories I established to perpetuate the original location of this corner.

Berntsen Monument - 30" (Set flush with the surface.)

- P.K. Nail in 8" Maple, N 38° E, 18.54'
- P.K. Nail in 13" Maple, S 55° E, 51.36'
- P.K. Nail in 11" Maple, S 55° W, 13.49'
- P.K. Nail in 8" Maple, N 35° W, 54.70'

Dated at Tomahawk, Wis., this 31st day of August, 19 78.

Signature Lester J. Schmit Title Land Surveyor Registration No. S-1192
(County Surveyor, Registered Land Surveyor, or other duly authorized official)

Office of Register of Deeds, County of....., I hereby certify that the within
instrument was filed in this office for record on the.....day of....., 19.....
at.....o'clock..... M.

.....
(Register of Deeds)

By.....Deputy