

CERTIFIED LAND CORNER RESTORATION

Index No. 9-17

History of original corner establishment:


Surveyor: Joseph W. Jenkins  
Date: 26 September 1862  
Monumentation: Wood Post  
Witnesses: Black Pine 8, S 7° W, 248 links  
Yellow Pine 10, S 3° E, 230 links  
Yellow Pine 16, N 4° E, 443 links  
White Pine 14, N 2° W, 447 links

Description of corner evidence found: Found post point in wet, open swamp, for the corner. Top of post was rotted off and the upper portion of the post could not be found.

I, Lester J. Schmitt, do hereby certify that on the 9<sup>th</sup> day of November, 1984, I found evidence of the Northeast corner of Section 27 Township 35 North, Range 5 East, Fourth, Principal Meridian, as described hereon; and that from this evidence I established a new monument and accessories as described hereon to perpetuate the original location of this corner.

Resident witnesses:

.....  
.....  
.....

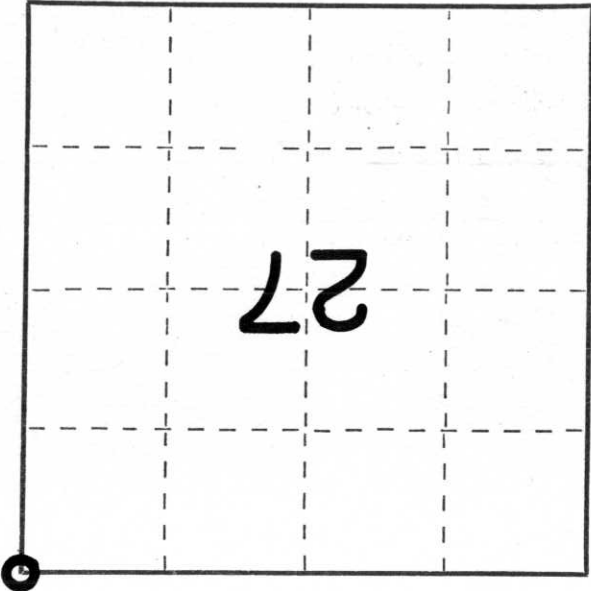

Description of monument and accessories I established to perpetuate the original location of this corner. Set Bernitsen monument for the corner to replace post point. Mounded sand & a couple of rock around the Bernitsen to stabilize it. Pushed post point into swamp 1.5' east of actual corner. See reverse side for diagram. Witnessed by: 5" black spruce, N 58° E, 29.98', 6" tamarack, S 88° E, 66.28', 8" norway pine, S 41° W, 86.35', 12" white pine, N 35° W, 145.70'

Dated at Tomahawk, Wis., this 11<sup>th</sup> day of November, 1984, Registration No. S-1192  
Signature: *Lester J. Schmitt* Title: Land Surveyor (County Surveyor, Registered Land Surveyor, or other duly authorized official)  
Office of Register of Deeds, County of \_\_\_\_\_, I hereby certify that the within instrument was filed in this office for record on the \_\_\_\_\_ day of \_\_\_\_\_, 19\_\_\_\_ at \_\_\_\_\_ o'clock \_\_\_\_\_ M.

By \_\_\_\_\_ Deputy  
(Register of Deeds)

State of Wisconsin }  
County of Lincoln } ss.

○ = Corner monument restored.