


CERTIFIED LAND CORNER RESTORATION

Index No. Q-25

State of Wisconsin }  
County of Lincoln } ss.

I Lester J. Schmit do hereby certify that on the 12th day of January, 1978, I found evidence of the Southeast corner of Section 24 Township 35, North, Range 5 East, Fourth, Principal Meridian, as described hereon; and that from this evidence I established a new monument and accessories as described hereon to perpetuate the original location of this corner.

Resident witnesses:

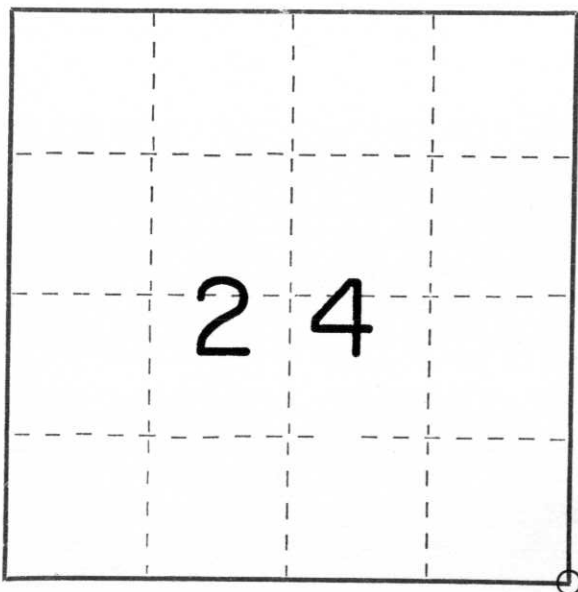

○ = Corner monument restored.

History of original corner establishment:

Surveyor: Alfred Millard  
Date: August 1860  
Monumentation: Wood Post  
Witnesses: 6" Tamarack, S 40° W, 15 links  
6" Spruce, S 38° E, 7 links  
7" Spruce, N 59° E, 10 links  
8" Spruce, N 22° W, 6 links

Description of corner evidence found:

Found a 2½" x 2½" x 24" iron bar at the surface of a private drive which runs southerly off from County Trunk Highway "CC".

Description of monument and accessories I established to perpetuate the original location of this corner.

Set 30" Berntsen monument to replace iron bar for corner. Top of Berntsen monument is 4" below surface of driveway.

Witnesses: 1" iron pipe, N 30° E, 78.64'  
5" Red Maple, S 20° E, 45.32'  
6" Red Maple, S 79° W, 44.80'  
6" Jack Pine, N 24° W, 99.41'

Dated at Tomahawk, Wis., this 10th day of September, 1982.

Signature Lester J. Schmit Title Land Surveyor Registration No. S-1192  
(County Surveyor, Registered Land Surveyor, or other duly authorized official)

Office of Register of Deeds, County of \_\_\_\_\_, I hereby certify that the within instrument was filed in this office for record on the \_\_\_\_\_ day of \_\_\_\_\_, 19\_\_\_\_ at \_\_\_\_\_ o'clock \_\_\_\_\_ M.

(Register of Deeds)

By \_\_\_\_\_ Deputy