


# U.S. PUBLIC LAND SURVEY MONUMENT RECORD

NOTE: THIS FORM IS INTENDED AND DESIGNED TO FULFILL ALL REQUIREMENTS OF WISCONSIN ADMINISTRATIVE CODE CHAPTER A-E 7.08 U.S. PUBLIC LAND SURVEY MONUMENT RECORD (3) (a)(b)(c)(d)(e)(f)(g)(h)(i). AN ADDITIONAL SHEET MAY BE ADDED IF NECESSARY TO CONFIRM WITH SAID REQUIREMENTS.

(a) CORNER LOCATION:  
 SOUTH QUARTER CORNER  
 SECTION 28, TOWNSHIP 35 NORTH, RANGE 5 EAST  
 TOWN OF WILSON, LINCOLN COUNTY  
 LINCOLN COUNTY COORDINATES:  
 NORTHING: 232525.856  
 EASTING: 346541.865

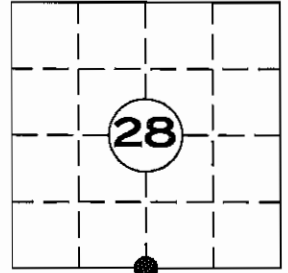


(b) HISTORY OF ORIGINAL CORNER:  
 ORIGINAL SURVEYOR: JOSEPH H. JENKINS SEPT. 1862 - OCT. 1862  
 TAMARAC 6 S 31° W 23 LINKS  
 TAMARAC 8 N 35° E 25 LINKS

(f)(g)(h) DESCRIPTION OF MONUMENT FOUND AT THIS CORNER AND IF IT WAS ACCEPTED STATE ALL EVIDENCE (MATERIAL, TESTIMONIAL, OCCUPATIONAL, PLATS, RECORDS, OTHER MONUMENTS) USED AS A BASIS FOR ESTABLISHING LOCATION. IF REESTABLISHED THROUGH LOST CORNER PROPORTIONATE METHODS, INDICATE ALL MONUMENTS, DISTANCES, AND DIRECTIONS USED TO ESTABLISH. INDICATE TYPE OF MONUMENT AND SIGN POST FOUND OR SET.

BOUNDARY SURVEY BY RLS 1418 DATED 12-28-84 AND PREPARED 3-6-87 FOR OWENS-ILLINOIS FOREST PRODUCTS SHOWS THE SOUTH QUARTER COMPUTED AT MID POINT BETWEEN THE SE AND SW CORNERS OF SECTION 28.

27 DECEMBER 2011; FOUND A 2in. OD IRON PIPE IN GOOD CONDITION, LOCATION FIT MID POINT DISTANCE BETWEEN THE SE CORNER AND SW CORNER OF SECTION 28. ACCEPTED MONUMENT AND SET FOUR NEW WITNESS MONUMENTS.

(c)(d)(e) PLAN VIEW OF CORNER WITH TIES TO AT LEAST FOUR WITNESSES. IF IN DISAGREEMENT WITH PREVIOUSLY ESTABLISHED CORNER, SHOW THE DISTANCE BETWEEN THE TWO CORNERS AND ALSO INDICATED THE TIE TO THE DISPUTED CORNER.

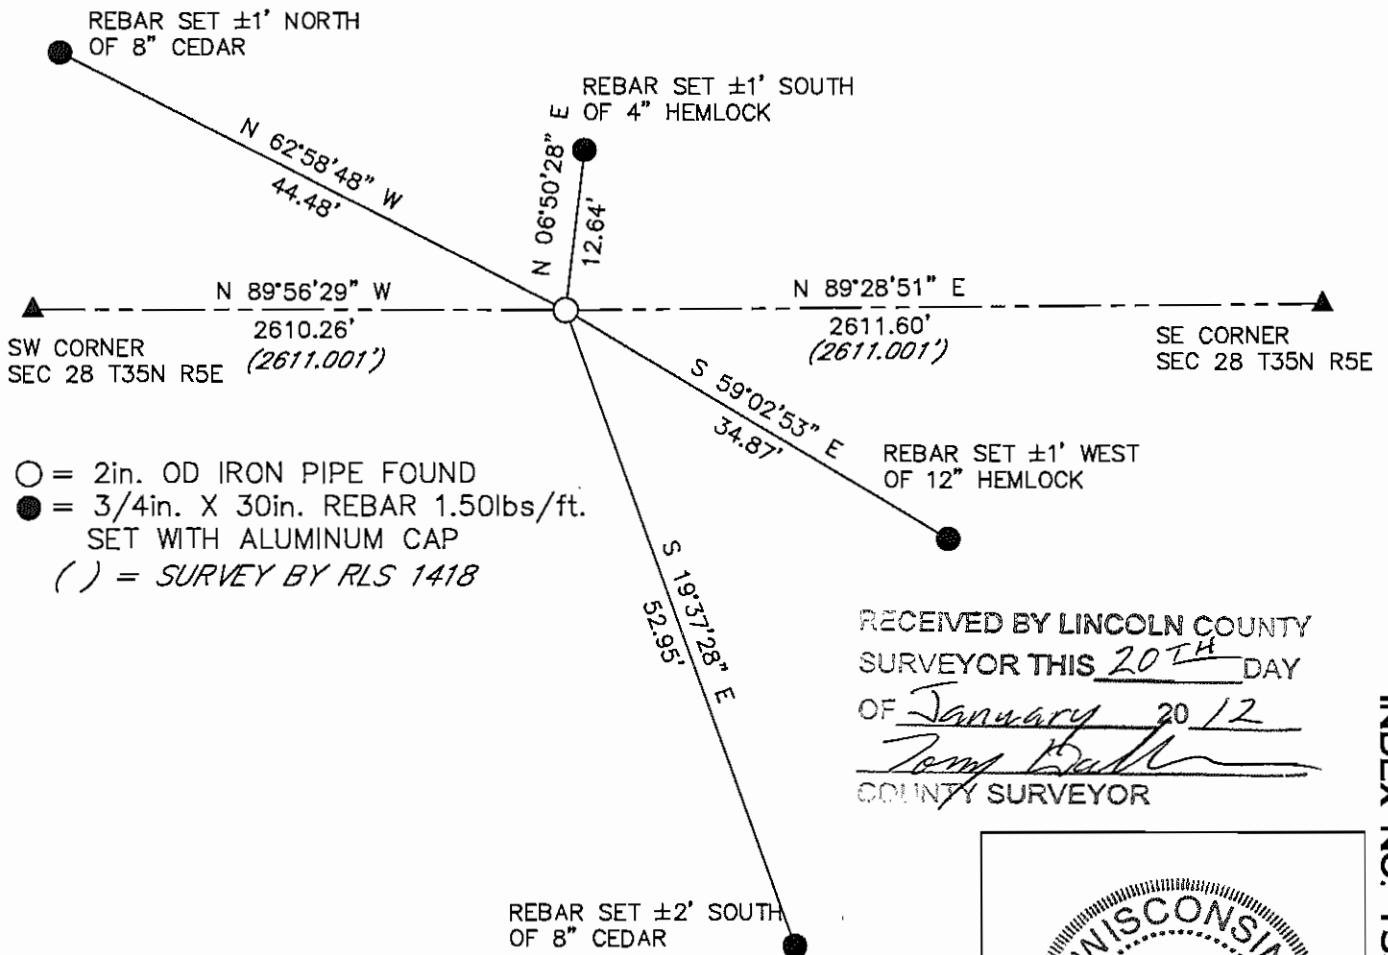

RECEIVED BY LINCOLN COUNTY  
 SURVEYOR THIS 20<sup>TH</sup> DAY  
 OF January 20 12  
*Tom Bull*  
 COUNTY SURVEYOR



I DARREN B. KRZANOWSKI, REGISTERED LAND SURVEYOR NO. 2663, HEREBY CERTIFY THAT THE CORNER LOCATION ON THIS RECORD WAS REFERENCED BY ME OR UNDER MY DIRECTION AND CONTROL AND THAT THIS U.S. PUBLIC LAND SURVEY MONUMENT RECORD IS COMPLETE TO THE BEST OF MY KNOWLEDGE AND BELIEF.

*Darren Krzanowski*  
 DARREN B. KRZANOWSKI RLS 2663  
 DATED THIS 16TH DAY OF JANUARY, 2012

INDEX NO. T35N R5E U11









