
SS.

as described hereon; and that from this evidence location of this corner. as described hereon to perpetuate the original Township..... evidence of the West 1/4 certify that on the..... I established a new monument and accessories6..East......, Fourth, Principal Meridian, corner of Section 2 Lester J. Schmit, 1976..., I found, North, Range, do hereby

Resident witnesses:

		1
		1
		ì
		i
i		i
		1
		1
		i
i		į
		1
		i
- 1		i
- 1		ì
1		
- 1		İ

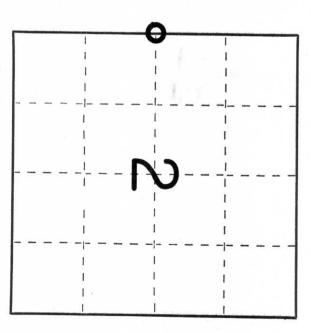

O = Corner monument restored.

By.

CERTIFIED LAND CORNER RESTORATION

Index No.

History of original corner establishment:

Witnesses: W. Pine 20 N 30° E 92 LKS. Y. Pine 16 S 47° W 108 LKS. Monumentation: 1" X 24" iron rod Date: 22 October 1861 Surveyor; Alfred Millard

Description of corner evidence found:

1" X 24" iron rod, 4" below surface of the ground along the centerline of Town Road.

Witnesses: P.K. Nail in 18" White Pine; S 32°30' E; 75.9" P.K. Nail in P.P. #3506; S 28°30" W; 73.2

P.K. Nail in P.P. #3506; N 32°30' W; 78.3'

Berntsen Monument - 30" (Set 4" below surface of road)
Placed 1" X 24" iron rod adjacent to Berntsen Description of monument and accessories I established to perpetuate the original location of this corner. corner of Section 2. Monument, with top of said iron rod 12" below surface of road. Berntsen Monument is West 1/4

Witnesses: P.K. Nail in P.P. #3506; N 20° E; 63.47" 2W17

Office of Register of Deeds, County of, I hereby certify that the within instrument was filed in this office for record on theday of, 19, 19, ato'clock M.	Signature Jeatte A. Schmid Title Land Surveyor Surveyor Registration No. S-1192 (County Surveyor, Registered Land Surveyor, or other duly authorized official)	Dated at Tomahawk Wis., this 11th day of June 1976

(Register of Deeds) Deputy