

CERTIFIED LAND CORNER RESTORATION

Index No. S-21

State of Wisconsin }
County of Lincoln } ss.

History of original corner establishment:

Date of Original Survey: June 1861
Survey Performed by: Alfred Millard- Deputy Surveyor

Witness: 5" Tamarack, N30°E, 14 Links
5" Tamarack, N6°W, 19 Links

I John H. Fisher do hereby certify that on the 19 day of June, 1979, I found evidence of the West one quarter corner of Section 25 Township 35, North, Range 7, Fourth, Principal Meridian, as described hereon; and that from this evidence I established a new monument and accessories as described hereon to perpetuate the original location of this corner.

Description of corner evidence found:

1-1/2" Well point, fences north, south and west

Resident witnesses:


none

Description of monument and accessories I established to perpetuate the original location of this corner.

Set Lincoln County Berntsen Monument

Witness:

6" White Pine S74°W, 24.8 feet
8" White Pine, N86°W, 37.6 feet
8" White Pine, N66°W, 11.7 feet
6" White Pine, N58°E, 45.4 feet

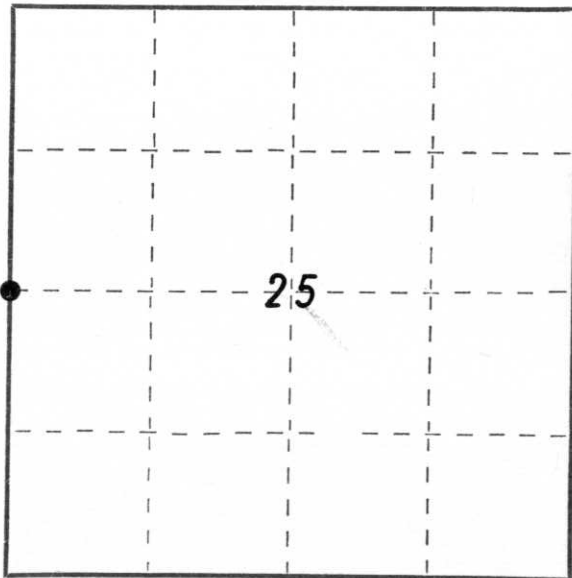

○ = Corner monument restored.



Dated at Minocqua, Wis., this 29th day of June, 1979.

Signature John H. Fisher Title Registered Land Surveyor Registration No. S-836
(County Surveyor, Registered Land Surveyor, or other duly authorized official)

Office of Register of Deeds, County of _____, I hereby certify that the within instrument was filed in this office for record on the _____ day of _____, 19____ at _____ o'clock _____ M.

(Register of Deeds)

By _____ Deputy



7 2:22 PM



40527
7



7 2:25 PM