

CERTIFIED LAND CORNER RESTORATION


Index No. 0-11

State of Wisconsin }  
County of Lincoln } ss.

I Lester J. Schmit, do hereby  
certify that on the 29th day  
of July, 1980, I found  
evidence of the North 1/4  
corner of Section 33  
Township 35, North, Range  
7 East, Fourth, Principal Meridian,  
as described hereon; and that from this evidence  
I established a new monument and accessories  
as described hereon to perpetuate the original  
location of this corner.

Resident witnesses:

Guy Myers  
.....  
.....  
.....

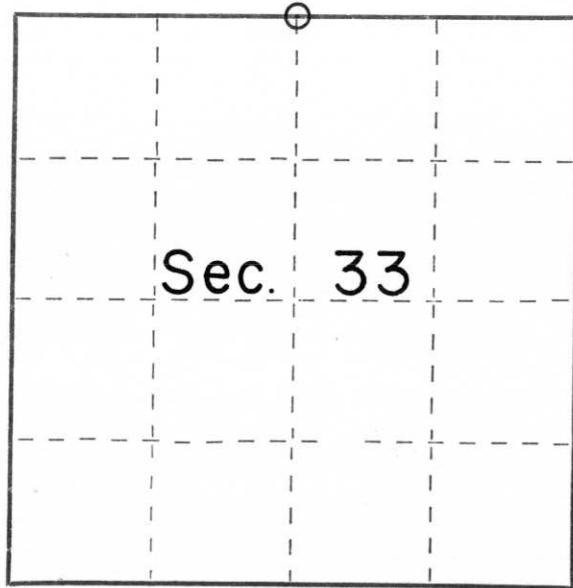

○ = Corner monument restored.

History of original corner establishment:

Surveyor: Alfred Millard  
Date: 8 August 1860  
Monumentation: Wood Post  
Witnesses: 9" White Pine, N 32° E, 16 links  
9" White Pine, S 38° W, 7 links

Description of corner evidence found:

A 1 1/4" well point & pieces of rotted wood post in the hole by the well point. This location was verified by Guy Myers who had lived & farmed this area over 60 years back.

Description of monument and accessories I established to perpetuate the original location of this corner.

Replaced the well point with a 30" Berntsen monument for the corner  
Witnessed by: 14" White Birch, N 89° E, 22.16'  
6" Oak, S 62° E, 52.36'  
8" Norway Pine, S 47° W, 61.07'  
5/8" iron rod, N 21° W, 21.76'

Dated at Tomahawk, Wis., this 4th day of August, 1980

Signature Lester J. Schmit Title Land Surveyor Registration No. S 1192  
(County Surveyor, Registered Land Surveyor, or other duly authorized official)

Office of Register of Deeds, County of....., I hereby certify that the within  
instrument was filed in this office for record on the.....day of....., 19.....  
at.....o'clock..... M.

.....  
(Register of Deeds)

By.....Deputy