U.S. PUBLIC LAND SURVEY MONUMENT RECORD

Note: This form is intended and designed to fulfill all requirements of the Wisconsin Administrative Code, Chapter A-E 7.08 U.S. Public Land Monument Record (3)(a)(b)(c)(d)(e)(f)(g)(h)(i). An additional sheet may be added if necessary to confrom with said requirements.

(a) CORNER LOCATION:

COORDINATES

north west corner of Section 9

North:

Township 31 North


East:

Range 4 East Town of Corning Control Station: Latitude:

County of Lincoln

Longitude:

Datum Method

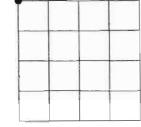

(b) HISTORY OF ORIGINAL CORNER ESTABLISHMENT

SECTION 9

Original Surveyor: W.E. Daugherty

Original B.T.'S

Date of Survey: Commenced December 1861

Birch 10" dia., N54°E 8 links

Completed January 1862

Ash 12" dia., S51°W 40 links

(f)(g)(h) DESCRIPTION OF MONUMENT FOUND AT THIS CORNER AND IF IT WAS ACCEPTED, STATE ALL EVIDENCE (MATERIAL, TESTIMONIAL, OCCUPATIONS, PLATS, RECORDS, OTHER MONUMENTS) USED AS A BASISFOR ESTABLISHING LOCATION. IF NOT ACCEPTED OF IF NOTHING WAS FOUND, STATE EVIDENCE USED AS BASIS FOR ESTABLISHING LOCATION. IF REESTABLISHED THROUGH LOST CORNER PROPORTIONATE METHODS INDICATE ALL MONUMENTS DISTANCES AND DIRECTIONS USED TO ESTABLISH. INDICATE TYPE OF MONUMENT AND SIGN POST FOUND OR SET.

Original Surveyor: W.E. Daugherty, at 80 chains set quarter post for corner to Sections 4, 5, 8 & 9.

W. H. Stuth: 3/6/87, recovered an iron pipe at the intersection of Cedar and Tower Roads, shows no bearing trees.

Michael L. Oestreich: 11/9/05, was unable to recover iron pipe by Stuth. I then tied to the west quarter corner of Section 9 and the southwest corner of Section 9, previous survey map by Stuth indicates he set west quarter corner and southwest corner for Section 9 by single proportion measurement from the recovered southwest corner of Section 16. I contemplated setting the northwest corner of Section 9 by doubling through the southwest corner and west quarter corners. However I recovered the North Sixteenth Corner, a 1.6" dia. iron pipe, I then decided to double through the west quarter corner and North Sixteenth corner to reset the northwest corner of Section 9. The previous survey map by Stuth shows this distance to be 39.953 chains (2636.90') by doubling through the quarter corner and North Sixteenth Corner this distance is 2637.02. I set a Berntsen cast aluminum monument at this position for the corner, and I made witness ties as shown in plan below. The monument is 3' south of the centerline of Cedar Road, and 3' east of the southerly centerline extension of Tower Road. See map of Survey by Oestreich Surveying & Mapping, LLC dated 11/30/05 for more survey data relating to the subdivision of Section 9.

(c)(d)(e) PLAN VIEW OF CORNER WITH TIES TO AT LEAST 4 WITNESS MONUMENTS. IF IN DISAGREEMENT WITH PREVIOUSLY ESTABLISHED CORNER, SHOW THE DISTANCE BETWEEN THE TWO CORNERS AND ALSO 6" dia. Balsam

