

LINCOLN COUNTY U.S. PUBLIC LAND TIE SHEET RECORD

SECTION 20
TOWNSHIP 31N
RANGE 4 E

203144
NO.

CORNING
CITY, VILLAGE, TOWN


LANDMARK

CORNER INDENTITY: 1.5" IRON PIPE w/WOOD POST

LINCOLN COUNTY COORDINATE: N: 114315.8092
E: 306386.2674

DATE OF SURVEY: November 1, 2006
SURVEY PARTY: Rutzen/Dahlvig

- FOUND
- SET
- RE-SET
- RE-TIED

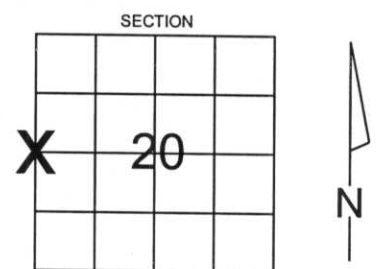

Description of monument found at this corner and if was accepted, state all evidence (material, testimonial, occupational, plats, records, other monuments) used as a basis for accepting. If not accepted or if nothing was found, state evidence used as basis for establishing location. If reestablished through lost corner proportionate methods, indicate all monuments, distances and directions used to establish.

BASIS FOR MONUMENT LOCATION:

(DESCRIBE METHOD OF SURVEY AND CORNER AUTHENTICATION)
Wood post and 1.5" iron pipe was found at the corner. Found monument was held based on comparison to original notes.




CERTIFIED CORRECT:

Ronald Jacobson RLS 2059-008
Registered Land Surveyor
DATE: November 17, 2006

COMPANY: Central Wisconsin Engineers & Architects
5707 Schofield Ave.
Weston, Wisconsin 54476
(715) 359-9400

TIE SKETCH: SHOW MINIMUM OF FOUR (4) HORIZONTAL TIE DISTANCES TO FIXED WITNESS MONUMENTS. DESCRIBE ALL MONUMENTS FOUND OR SET. ALL DISTANCES SHOWN IN US SURVEY FEET.

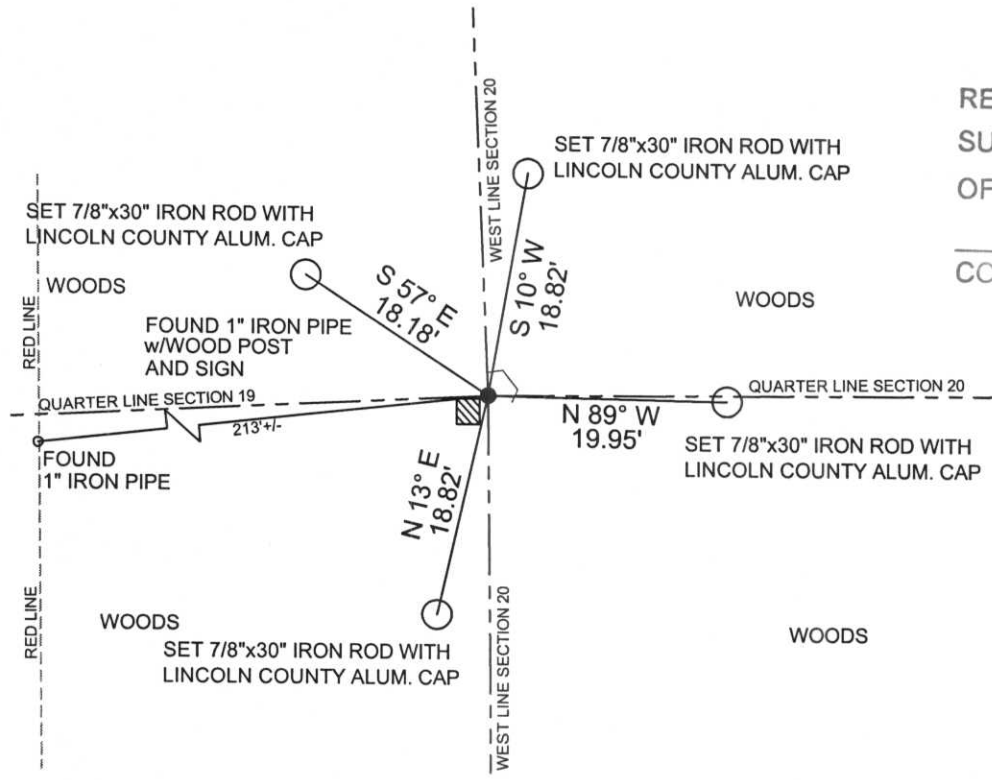

RECEIVED BY LINCOLN COUNTY
SURVEYOR THIS 22ND DAY
OF November 20 06

COUNTY SURVEYOR

COORDINATES ARE REFERENCED TO LINCOLN COUNTY COORDINATE SYSTEM AS DEVELOPED BY THE WI. DEPARTMENT OF TRANSPORTATION AND ARE BASED ON GPS OBSERVATIONS TO CONTROL POINTS AS SUPPLIED BY LINCOLN COUNTY.

NOT TO SCALE
BEARINGS REFERENCED TO MAGNETIC NORTH











