## U.S. PUBLIC LAND SURVEY MONUMENT RECORD

Note: This form is intended and designed to fulfill all requirements of Wisconsin Ace. Public Land Survey Monument Record (3) (a) (b) (c) (d) (e) (f) (g) (h) (i). An add conform with said requirements.	dministrative Code, Chapter A-E 5.02, U.S Iditional sheet may be added if necessary to
(a) Corner location: Township 31 North	
RangeEast	
Town/City/Village CORNING	


Section (b) (f) (g) (h) Description of monument found at this corner and if it was accepted, state all evidence (material, testimonial, occupational, plats, records, other monuments) used as a basis for accepting. If not accepted or if nothing was found, state evidence used as basis for establishing location. If reestablished through lost corner proportionate methods, indicate all monuments, distances and directions used to establish.

> No evidence of corner found when digging at the location. Set Berntsen Monument in middle of road in line with fences east and west.

> > RECEIVED AT LINCOLN COUNTY COURTHOUSE THIS 154 DESCRIPTION

24

(c) (d) (e) Plan view of corner with ties to at least 4 witness monuments. If in disagreement with previously established corner, show the distances between the two corners and also indicate the ties to the disputed corner.

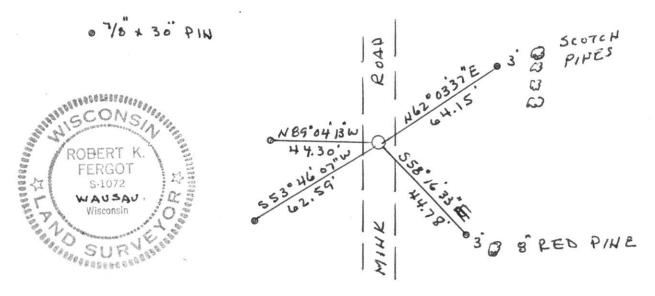

Robert K. Fergot

(type or print name) certify that the corner location on this record was determined by me or under my direction and control and that this U.S. Public Land Survey Monument Record is correct and complete to the best of my knowledge and belief.

Signature

April 20,1998

Date