

CERTIFIED LAND CORNER RESTORATION

Index No. E-9

State of Wisconsin }  
County of Lincoln } ss.

History of original corner establishment:  
Original wood post set by government surveyor

I Sheridan D. Schwark, do hereby certify that on the 3rd day of August, 1982, I found evidence of the Southwest corner of Section 4 Township 31, North, Range 5 East, Fourth, Principal Meridian, as described hereon; and that from this evidence I established a new monument and accessories as described hereon to perpetuate the original location of this corner.


Resident witnesses:

.....  
.....  
.....


Description of corner evidence found:

After being told about the corner by Elmer Kanitz (Town of Corning employee) we found a 7" x 7" x 36" granite monument (red). We reset the monument and established the references as shown below.

Description of monument and accessories I established to perpetuate the original location of this corner.

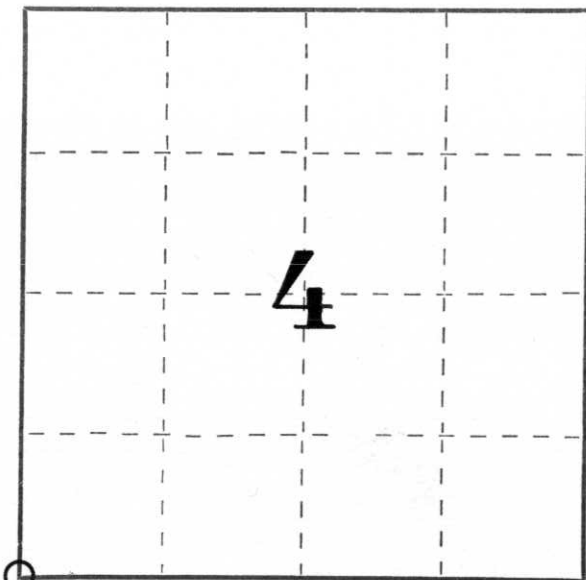

○ = Corner monument restored.

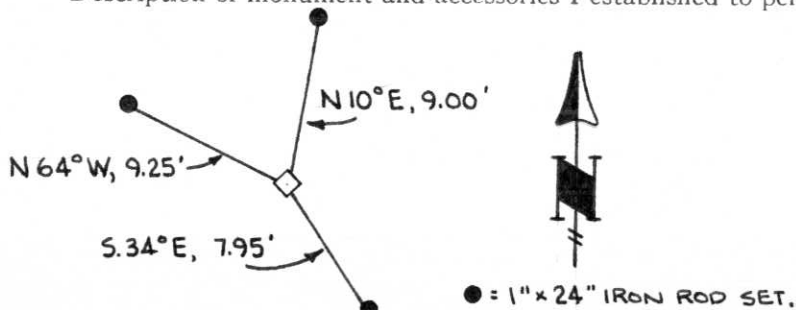

Dated at Merrill, Wis., this 4th day of August, 19 82.

Signature Sheridan D. Schwark Title Registered Land Surveyor Registration No. S-1205  
(County Surveyor, Registered Land Surveyor, or other duly authorized official)

Office of Register of Deeds, County of \_\_\_\_\_, I hereby certify that the within instrument was filed in this office for record on the \_\_\_\_\_ day of \_\_\_\_\_, 19 \_\_\_\_\_ at \_\_\_\_\_ o'clock \_\_\_\_\_ M.

.....  
(Register of Deeds)

By \_\_\_\_\_ Deputy