## U.S. PUBLIC LAND SURVEY MONUMENT RECORD

Note: This form is intended and designed to fulfill all requirements of Wisconsin Adm.	inistrative Code Chapter A.E.E.02.11.6
2011 0 0 11 11 11 11 11 11 11 11 11 11 11	ional sheet may be added it assessed to
The state of the s	ional sheet may be added if necessary to
(a) Corner location: Township 31 North	
TOTAL TOTAL	1 !   !   !
Panga 5 Fast	
Range 5 East	


Town/City/Village \_\_\_\_CORNING
County \_\_\_LINCOLN

Section 6

(b) (f) (g) (h) Description of monument found at this corner and if it was accepted, state all evidence (material, testimonial, occupational, plats, records, other monuments) used as a basis for accepting. If not accepted or if nothing was found, state evidence used as basis for establishing location. If reestablished through lost corner proportionate methods, indicate all monuments, distances and directions used to establish.

This corner was monumented with a stone prior to the town grader removing it according to local residents. To restablish the location I used the centerline of Elm Grove Road for alignment east — west and split the distance between the East 1/4 stone of sec. 6 and the East 1/4 stone of Sec. 7. This position fit a west bound fenceline.

(c) (d) (e) Plan view of corner with ties to at least 4 witness monuments. If in disagreement with previously established corner, show the distances between the two corners and also indicate the ties to the disputed corner.

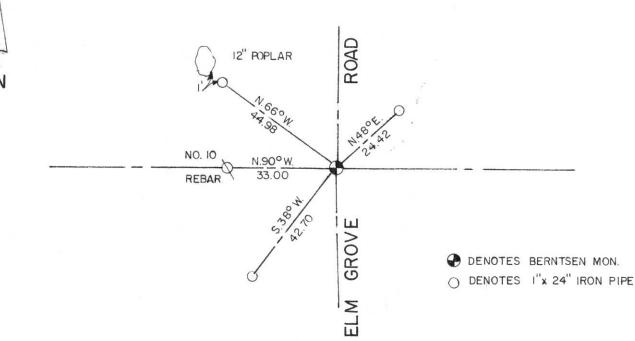

(i) I, THOMAS A. RADENZ

(type or print name) certify that the corner location on this record was determined by me or under my direction and control and that this U.S. Public Land Survey Monument Record is correct and complete to the best of my knowledge and belief.

Signature A. Faler

*12. 28-93*Date



Index No. E -5