

LINCOLN COUNTY U.S. PUBLIC LAND TIE SHEET RECORD

SECTION 11
TOWNSHIP 31N
RANGE 5 E

113156
NO.

CORNING
CITY, VILLAGE, TOWN

LANDMARK

CORNER INDENTITY: SURVEY NAIL


LINCOLN COUNTY COORDINATE: N: 121687.2457

E: 354058.4561

DATE OF SURVEY: June 20, 2006

SURVEY PARTY: Rutzen

- FOUND
- SET
- RE-SET
- RE-TIED

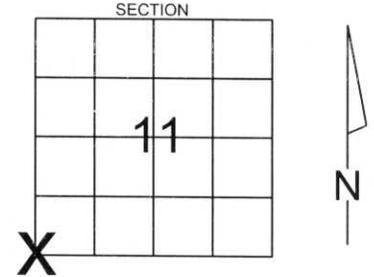

Description of monument found at this corner and if was accepted, state all evidence (material, testimonial, occupational, plats, records, other monuments) used as a basis for accepting. If not accepted or if nothing was found, state evidence used as basis for establishing location. If reestablished through lost corner proportionate methods, indicate all monuments, distances and directions used to establish.

BASIS FOR MONUMENT LOCATION:


(DESCRIBE METHOD OF SURVEY AND CONER AUTHENTICATION)
Monument was set based on right of way plat for S.T.H. 64



CERTIFIED CORRECT:
[Signature]
Ronald Jacobson RLS 2059-008
Registered Land Surveyor
DATE: June 23, 2006

COMPANY: Central Wisconsin Engineers & Architects
5707 Schofield Ave.
Weston, Wisconsin 54476
(715) 359-3400

TIE SKETCH: SHOW MINIMUM OF FOUR (4) HORIZONTAL TIE DISTANCES TO FIXED WITNESS MONUMENTS. DESCRIBE ALL MONUMENTS FOUND OR SET. ALL DISTANCES SHOWN IN US SURVEY FEET.

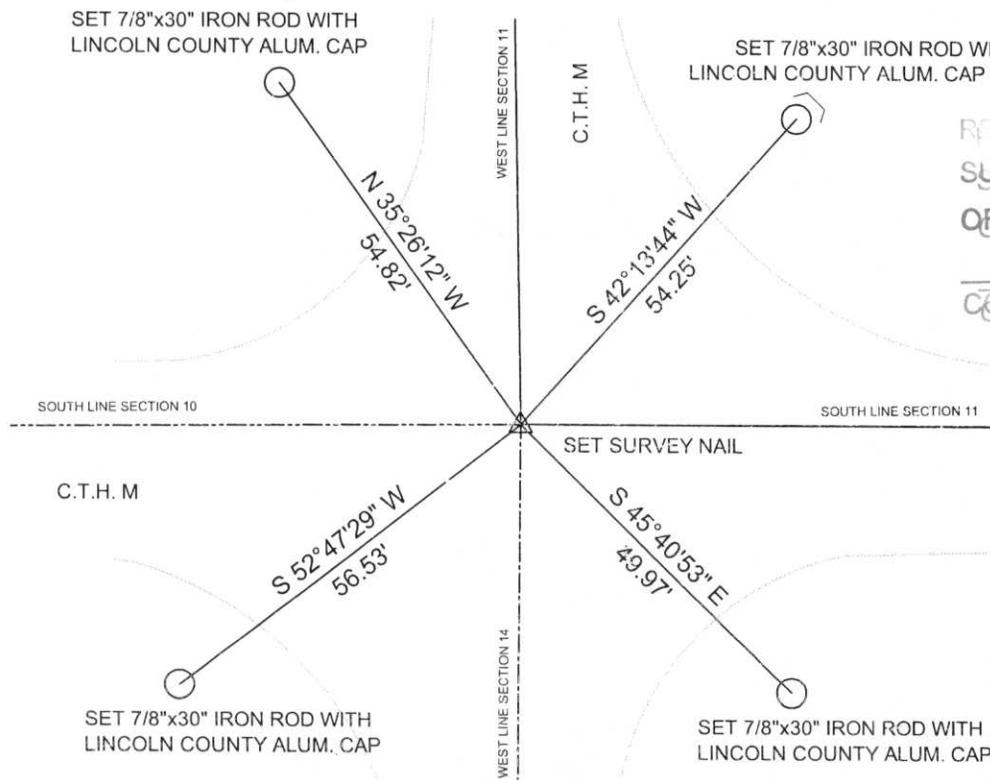


RECEIVED BY LINCOLN COUNTY
SURVEYOR THIS 30TH DAY
OF June 2006
[Signature]
COUNTY SURVEYOR

COORDINATES ARE REFERENCED TO LINCOLN COUNTY COORDINATE SYSTEM AS DEVELOPED BY THE WI. DEPARTMENT OF TRANSPORTATION AND ARE BASED ON GPS OBSERVATIONS TO CONTROL POINTS AS SUPPLIED BY LINCOLN COUNTY.

NOT TO SCALE
BEARINGS REFERENCED TO LINCOLN COUNTY COORDINATE SYSTEM

I-17



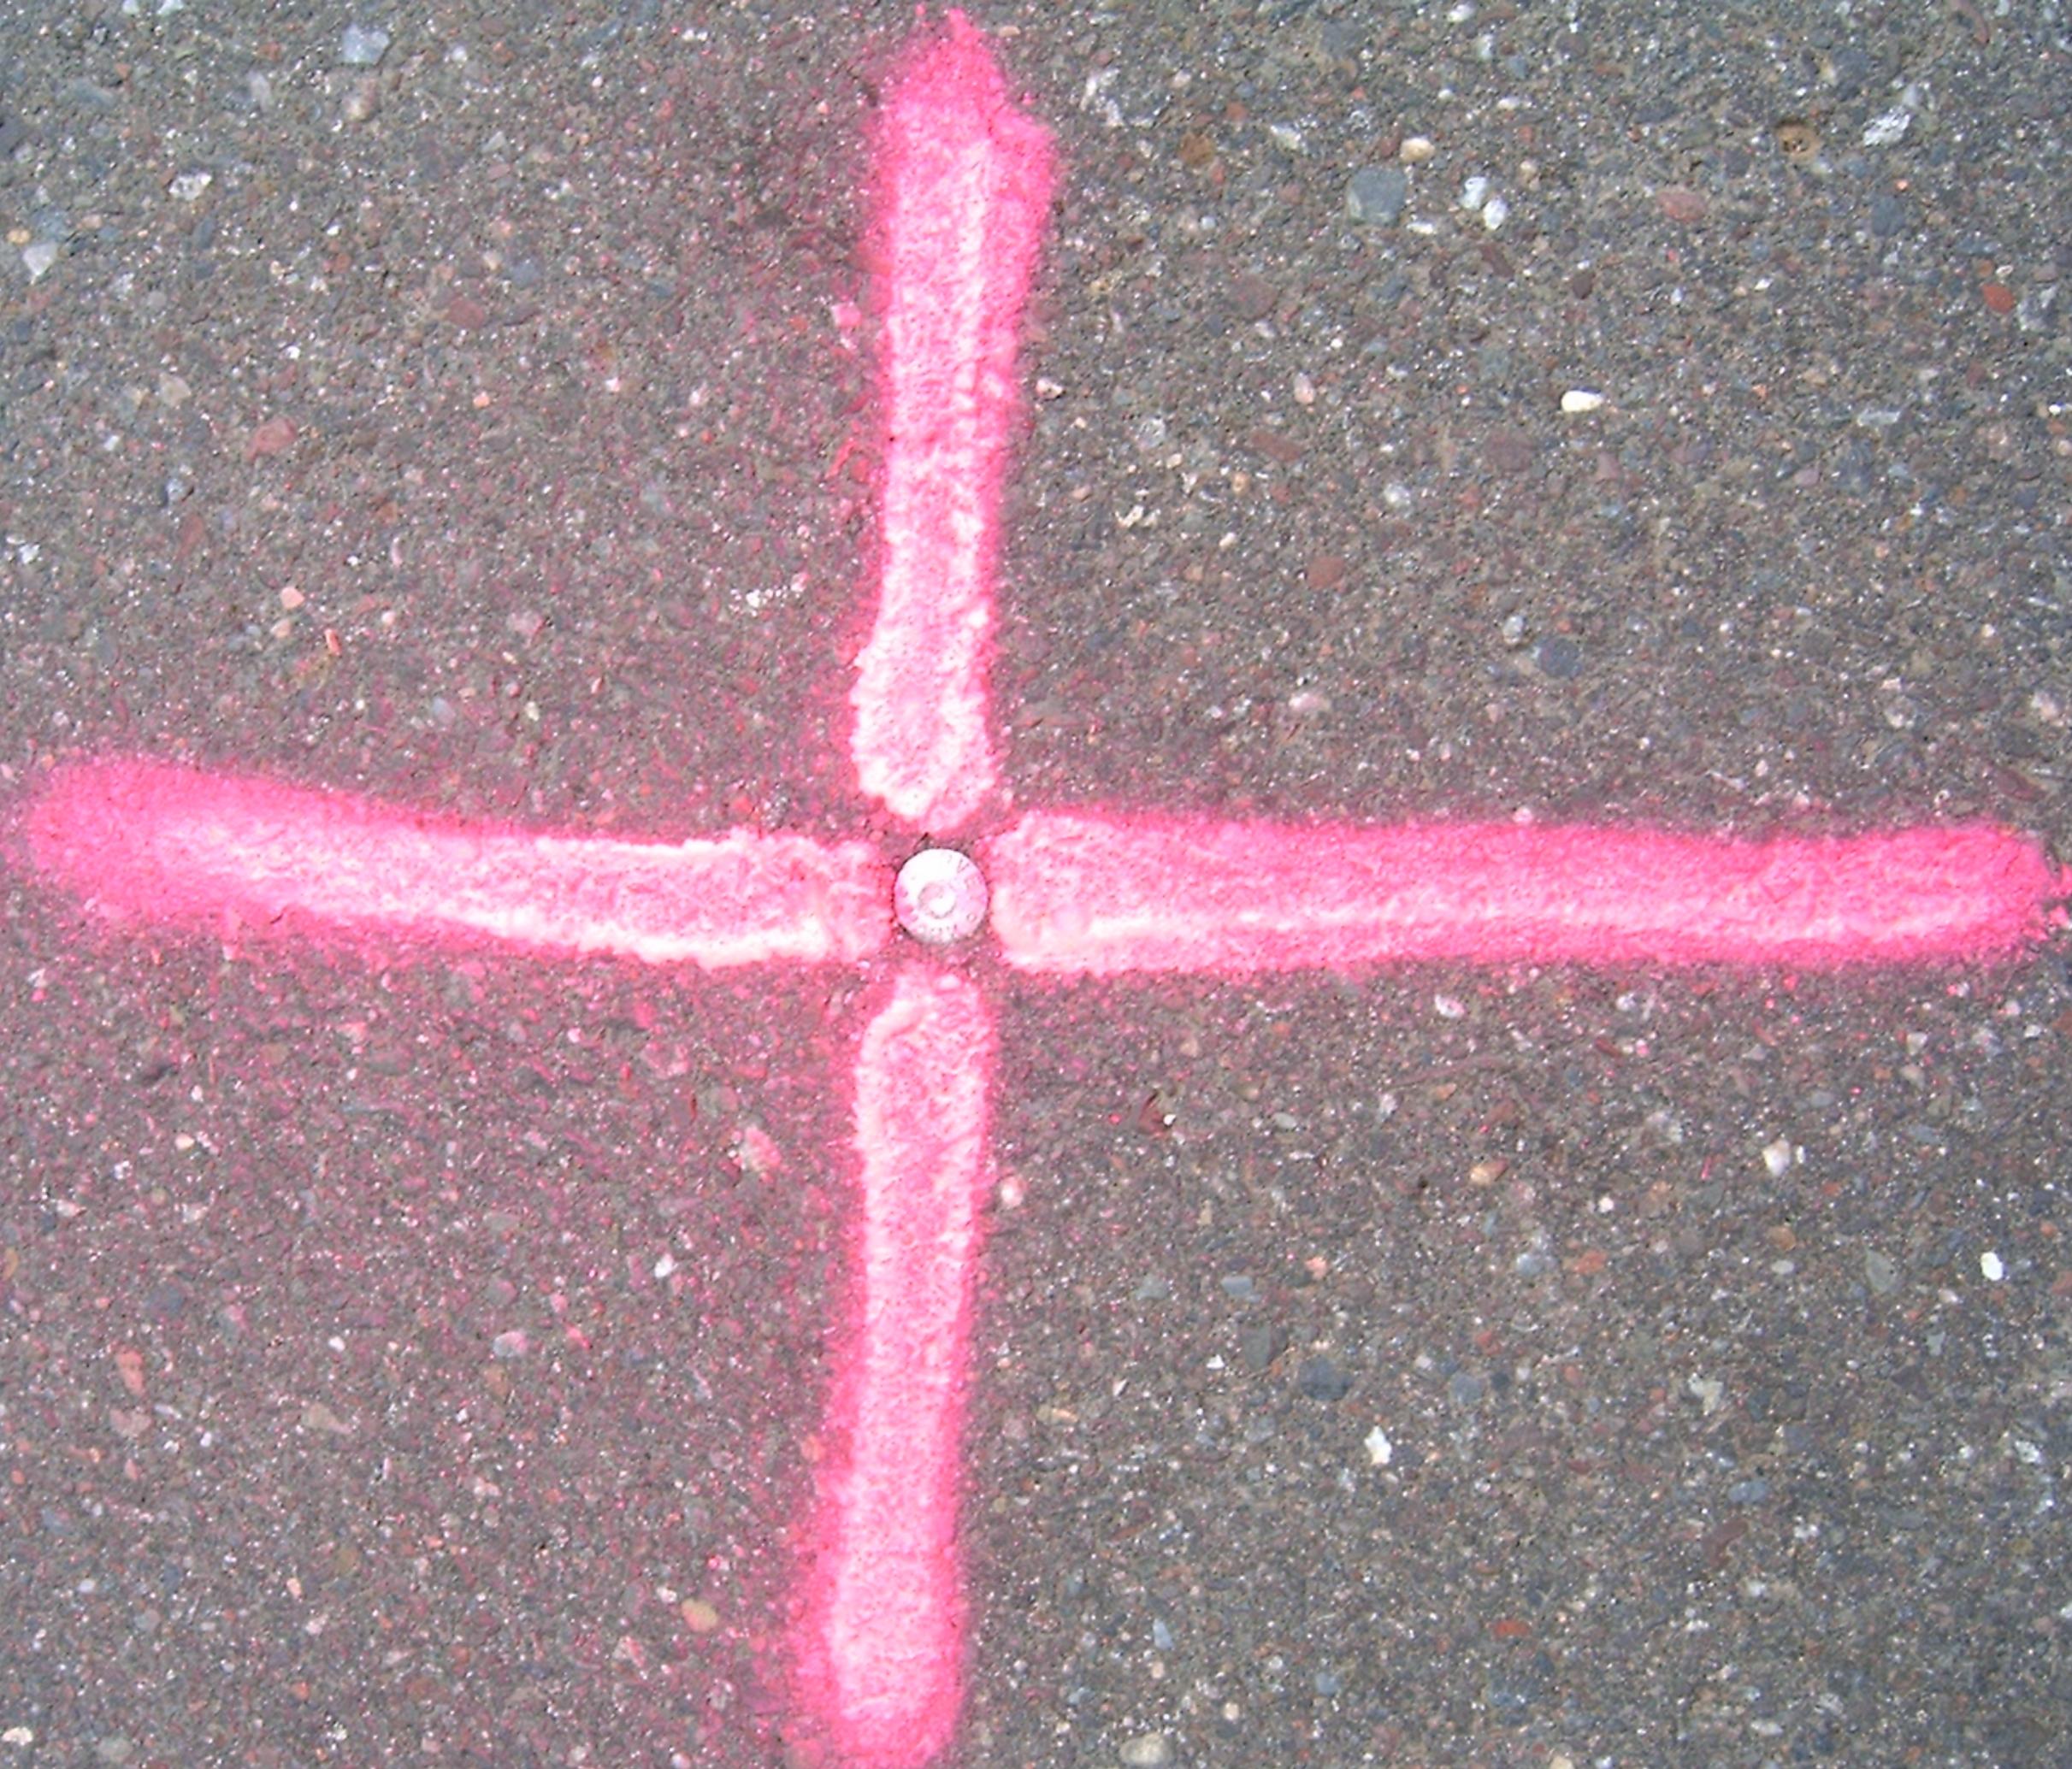



NORTH
COUNTY
M
←

STOP
AHEAD







WEST

COUNTY

M

