

LINCOLN COUNTY U.S. PUBLIC LAND TIE SHEET RECORD

SECTION 21
TOWNSHIP 31N
RANGE 5 E

213152
NO.

LANDMARK


CORNING
CITY, VILLAGE, TOWN

CORNER INDENTITY: 5" X 8" LIMESTONE MONUMENT

LINCOLN COUNTY COORDINATE: N: 116385.8700
E: 346067.7060

DATE OF SURVEY: June 21, 2006
SURVEY PARTY: Rutzen

FOUND
SET
RE-SET
RE-TIED

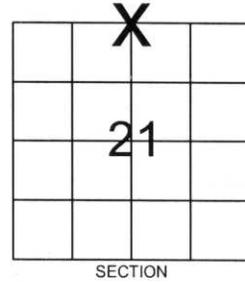

Description of monument found at this corner and if was accepted, state all evidence (material, testimonial, occupational, plats, records, other monuments) used as a basis for accepting. If not accepted or if nothing was found, state evidence used as basis for establishing location. If reestablished through lost corner proportionate methods, indicate all monuments, distances and directions used to establish.

BASIS FOR MONUMENT LOCATION:

(DESCRIBE METHOD OF SURVEY AND CONER AUTHENTICATION)

Found 6" X 6" limestone monument.



RECEIVED BY LINCOLN COUNTY
SURVEYOR THIS 30TH DAY
OF June 20 06
Tony Dall
COUNTY SURVEYOR

CERTIFIED CORRECT:


Ronald Jacobson
Registered Land Surveyor
RLS 2059-008

COMPANY: Central Wisconsin Engineers & Architects
5707 Schofield Ave.
Weston, Wisconsin 54476
(715) 359-3400

DATE: June 23, 2006

TIE SKETCH:

SHOW MINIMUM OF FOUR (4) HORIZONTAL TIE DISTANCES TO FIXED WITNESS MONUMENTS.
DESCRIBE ALL MONUMENTS FOUND OR SET. ALL DISTANCES SHOWN IN US SURVEY FEET.

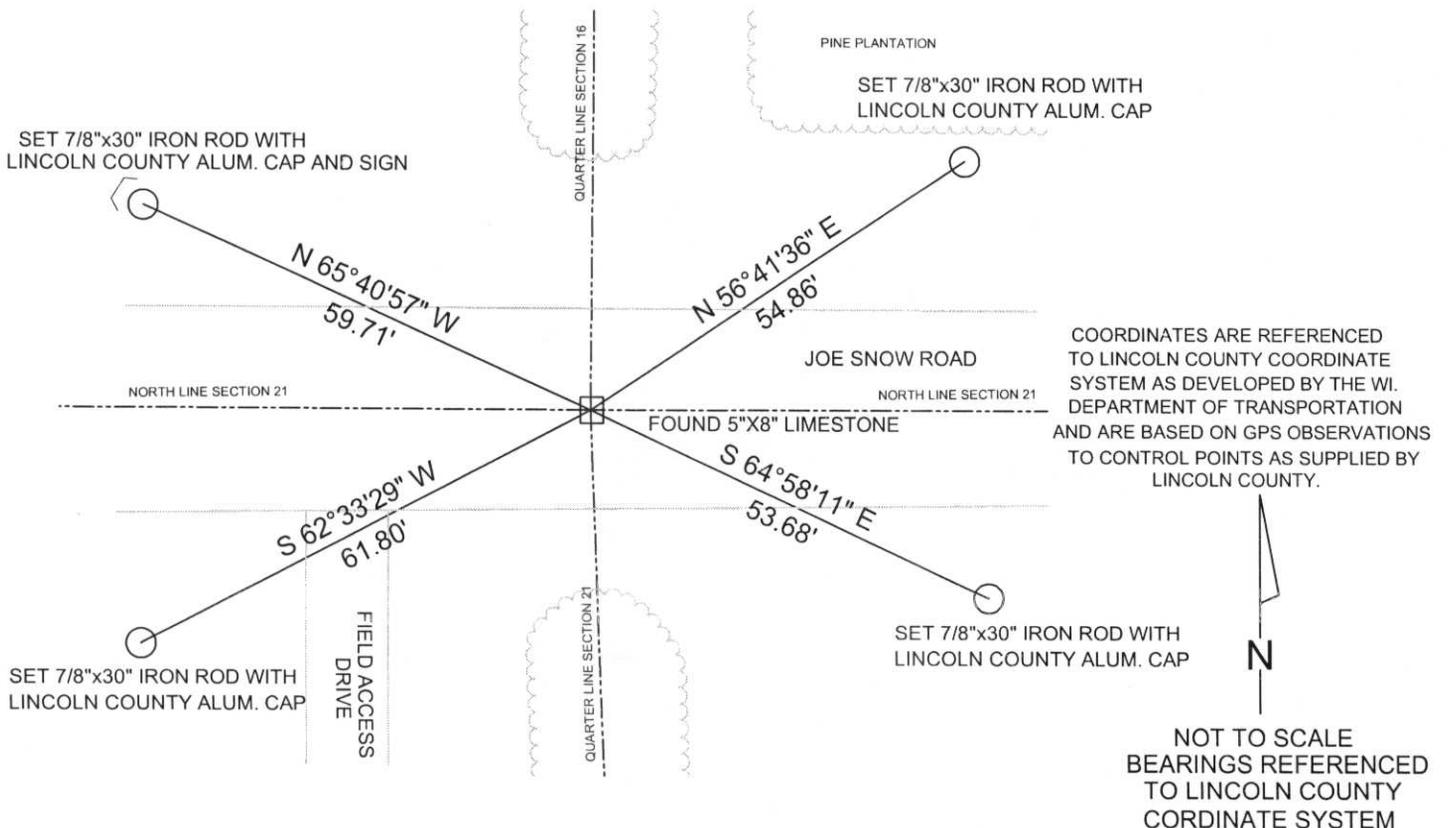

M-11















