

LINCOLN COUNTY U.S. PUBLIC LAND TIE SHEET RECORD

SECTION 21
TOWNSHIP 31N
RANGE 5E

213154
NO.

LANDMARK


CORNING
CITY, VILLAGE, TOWN

CORNER IDENTIFY: SURVEY NAIL

LINCOLN COUNTY COORDINATE: N: 113739.8256
E: 343428.5730

DATE OF SURVEY: July 6, 2006
SURVEY PARTY: Rutzen

FOUND
SET
RE-SET
RE-TIED

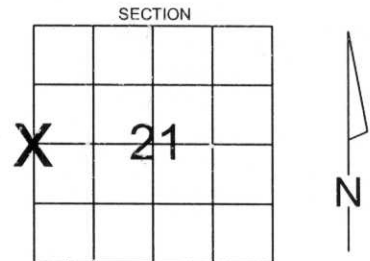


Description of monument found at this corner and if was accepted, state all evidence (material, testimonial, occupational, plats, records, other monuments) used as a basis for accepting. If not accepted or if nothing was found, state evidence used as basis for establishing location. If reestablished through lost corner proportionate methods, indicate all monuments, distances and directions used to establish.

BASIS FOR MONUMENT LOCATION:

(DESCRIBE METHOD OF SURVEY AND CONER AUTHENTICATION)

Monument was set based on evidence for Leafy Grove Road, a fenceline, and ownership evidence.

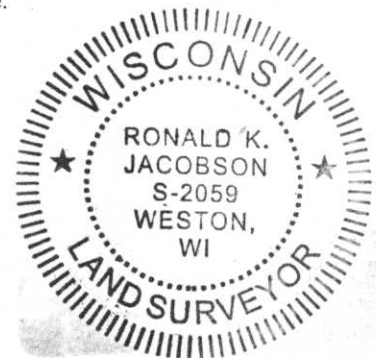

CERTIFIED CORRECT:


Ronald Jacobson
Ronald Jacobson RLS 2059-008
Registered Land Surveyor

DATE: July 10, 2006

COMPANY: Central Wisconsin Engineers & Architects
5707 Schofield Ave.
Weston, Wisconsin 54476
(715) 359-3400

TIE SKETCH:

SHOW MINIMUM OF FOUR (4) HORIZONTAL TIE DISTANCES TO FIXED WITNESS MONUMENTS.
DESCRIBE ALL MONUMENTS FOUND OR SET. ALL DISTANCES SHOWN IN US SURVEY FEET.

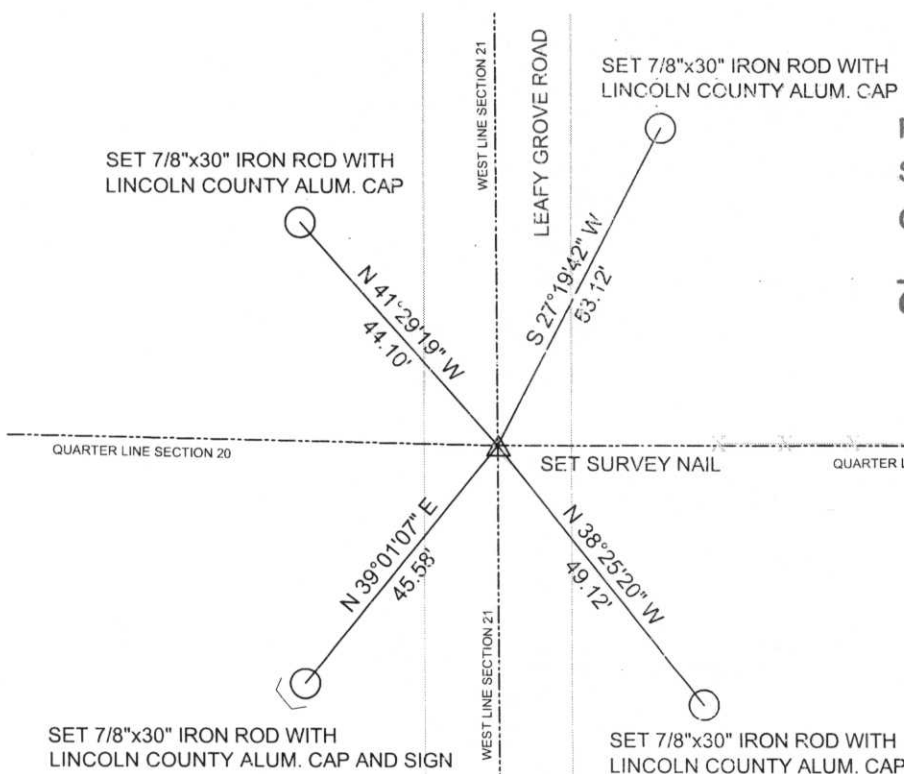

RECEIVED BY LINCOLN COUNTY
SURVEYOR THIS 12TH DAY
OF July 20 06
Tony Ball
COUNTY SURVEYOR

COORDINATES ARE REFERENCED TO LINCOLN COUNTY COORDINATE SYSTEM AS DEVELOPED BY THE WI. DEPARTMENT OF TRANSPORTATION AND ARE BASED ON GPS OBSERVATIONS TO CONTROL POINTS AS SUPPLIED BY LINCOLN COUNTY.

NOT TO SCALE
BEARINGS REFERENCED TO LINCOLN COUNTY COORDINATE SYSTEM

6-0







POSTED



