

CERTIFIED LAND CORNER RESTORATION


Index No. 5-13

State of Wisconsin }
County of Lincoln } ss.

I, Sheridan D. Schwark, do hereby certify that on the 21st day of June, 1978, I found evidence of the East one-quarter corner of Section 28 Township 31, North, Range 5 East, Fourth, Principal Meridian, as described hereon; and that from this evidence I established a new monument and accessories as described hereon to perpetuate the original location of this corner.

Resident witnesses:

.....
.....
.....

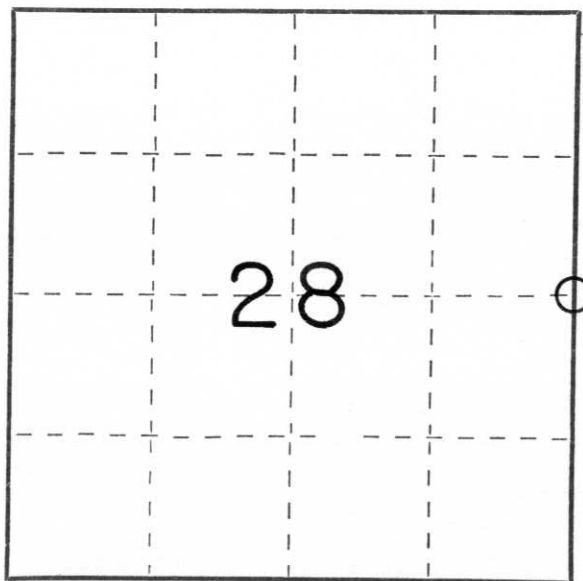

○ = Corner monument restored.

History of original corner establishment:

Date: October, 1852
Surveyor: Rick A. Chaney
Monument: Wood Post
Witnesses: 12" Birch, S87°E, 10 links
8" Birch, S51°30'W, 56 links

Description of corner evidence found:

We searched the fence and road intersection which we excavated with a backhoe and found a 6" x 6" broken stone monument. We found the broken off top and the base about 3' apart. We set a Lincoln County Berntsen Monument to replace the base of the broken stone.

Description of monument and accessories I established to perpetuate the original location of this corner.

We replaced the stone monument with a Lincoln County Berntsen Monument having the following witness monuments:

- 1 1/4" x 30" solid round iron rod set approximately 1' Southwest of a 13" blazed Maple bearing N40°E, 54.70'
- 1 1/4" x 30" solid round iron rod set approximately 1' West of a clump of six 3" Maples bearing S60°E, 34.00'
- 1 1/4" x 30" solid round iron rod set approximately 1' East of a fence post bearing S53°W, 32.30'
- 1 1/4" x 30" solid round iron rod set approximately 1' Southeast of a 12" Maple bearing N56°W, 35.55'

Dated at Merrill, Wis., this 23rd day of June, 1978.

Signature Sheridan D. Schwark Title Registered Land Surveyor Registration No. S-1205
(County Surveyor, Registered Land Surveyor, or other duly authorized official)

Office of Register of Deeds, County of _____, I hereby certify that the within instrument was filed in this office for record on the _____ day of _____, 19____ at _____ o'clock _____ M.

.....
(Register of Deeds)

By _____ Deputy