

CERTIFIED LAND CORNER RESTORATION

Index No. 4-15

State of Wisconsin }
County of LINCOLN } ss.

History of original corner establishment:

I FRANCIS X FOX, do hereby certify that on the _____ day of _____, 1971, I found evidence of the SOUTH 1/4 SECTION corner of 34 Township 31, North, Range S EAST, Fourth, Principal Meridian, as described hereon; and that from this evidence I established a new monument and accessories as described hereon to perpetuate the original location of this corner.

Description of corner evidence found:



CORNER STONE

Resident witnesses:

21.

Description of monument and accessories I established to perpetuate the original location of this corner.

SET 2 REFERENCE IRONS
AS SHOWN

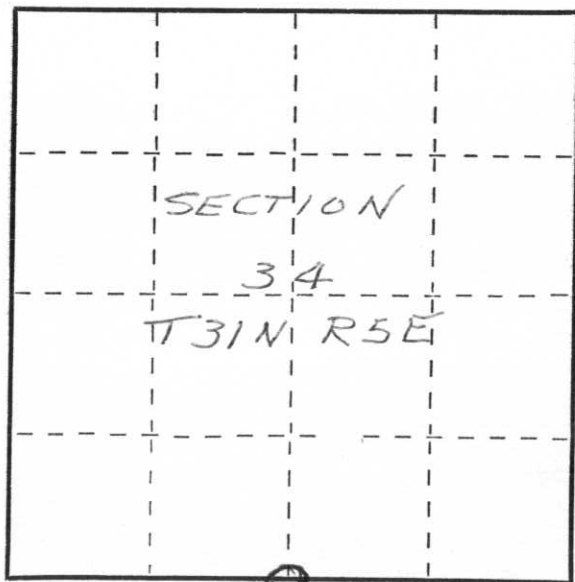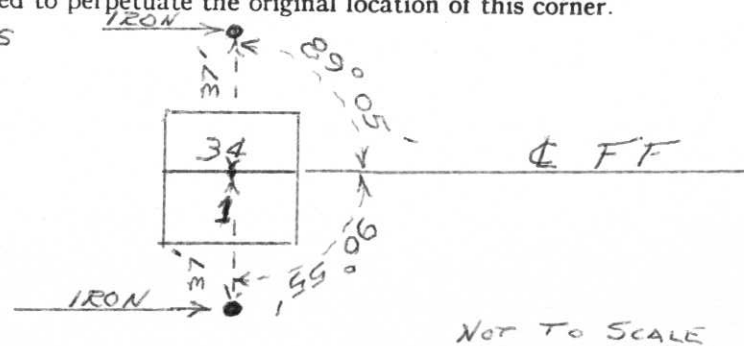

○ = Corner monument restored.

Dated at MERRILL, Wis., this 6TH day of DECEMBER, 1972.

Signature Francis X Fox Title Highway Commissioner Registration No. S 0046
(County Surveyor, Registered Land Surveyor, or other duly authorized official)

Office of Register of Deeds, County of _____, I hereby certify that the within instrument was filed in this office for record on the _____ day of _____, 19____ at _____ o'clock _____ M.

(Register of Deeds)

By _____ Deputy

CERTIFIED LAND CORNER RESTORATION

Index No. Y-15

State of Wisconsin }
County of LINCOLN } ss.

History of original corner establishment:

I FRANCIS X. FOX, do hereby certify that on the _____ day of _____, 1971, I found evidence of the SOUTH 1/4 SECTION corner of 34 Township 31, North, Range 5 EAST, Fourth, Principal Meridian, as described hereon; and that from this evidence I established a new monument and accessories as described hereon to perpetuate the original location of this corner.

Description of corner evidence found:



CORNER STONE

Resident witnesses:

21.

Description of monument and accessories I established to perpetuate the original location of this corner.

SET 2 REFERENCE IRONS
AS SHOWN

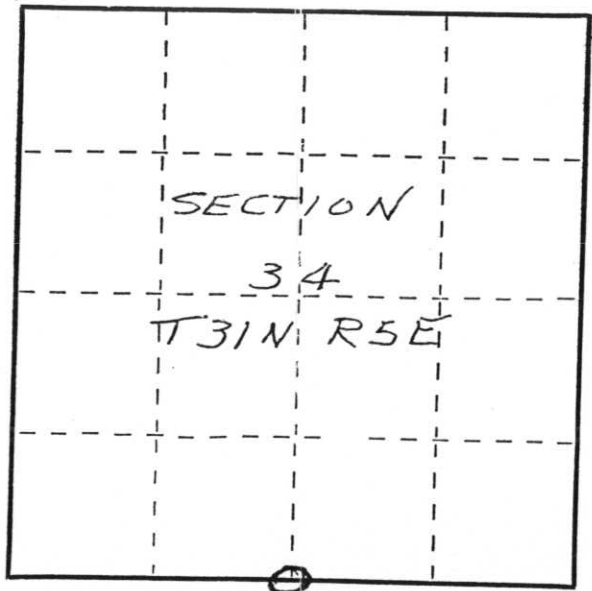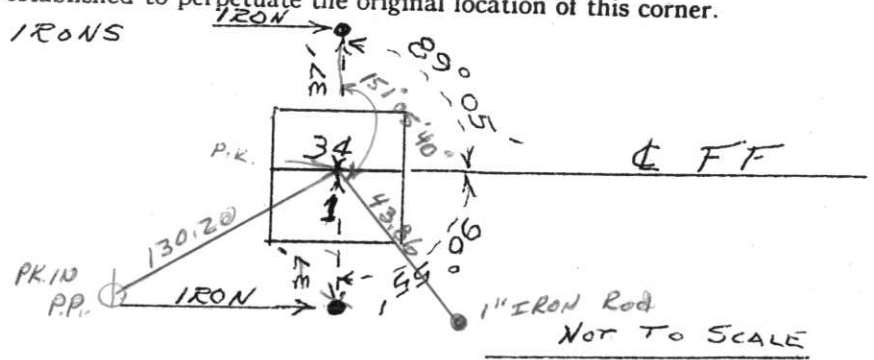

○ = Corner monument restored.

Dated at MERRILL, Wis., this 6TH day of DECEMBER, 1972.

Signature Francis X. Fox Title HIGHWAY COMMISSIONER Registration No. 50046
(County Surveyor, Registered Land Surveyor, or other duly authorized official)

Office of Register of Deeds, County of _____, I hereby certify that the within instrument was filed in this office for record on the _____ day of _____, 19____ at _____ o'clock _____ M..

(Register of Deeds)

By _____ Deputy

Robert Fergo
5-16-74





