

CERTIFIED LAND CORNER RESTORATION


Index No. E-23

State of Wisconsin }
County of Lincoln } ss.

I Sheridan D. Schwark, do hereby certify that on the 28th day of February, 19 77, I found evidence of the North ~~1/4~~ one-quarter corner of Section 12 Township 31, North, Range 6 East, Fourth, Principal Meridian, as described hereon; and that from this evidence I established a new monument and accessories as described hereon to perpetuate the original location of this corner.

Resident witnesses:

.....
.....
.....

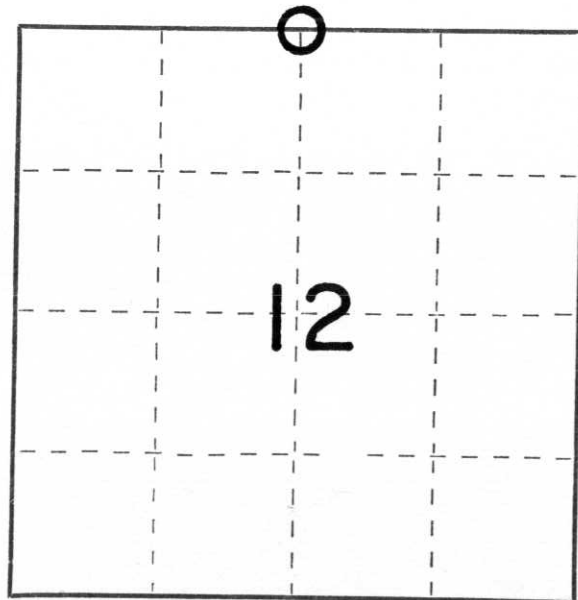

○ = Corner monument restored.

History of original corner establishment:

Surveyor: Albert & Frederick Ellis
Date: April 29, 1852
Monumentation: Wood post
Witnesses: 7" Hemlock S12°W 20L
10" Spruce N55°E 47L

Description of corner evidence found:

Found 6" x 6" stone monument with drill hole, down .75', next to steel fence post. No bearing trees found.

Description of monument and accessories I established to perpetuate the original location of this corner.

Witnessed stone monument as follows:

1'14" x 30" solid round iron rod bearing N5°E, 54.45'
Top of 3-1/2" diameter steel fence post bearing S88°E, 24.30'
Top of 3-1/2" diameter steel fence post bearing S1°30'W, 25.16'
P.K. nail in 6" Pine, bearing West, 12.12'

Dated at Merrill, Wis., this 8th day of July, 19 77.

Signature Sheridan D. Schwark Title Registered Land Surveyor Registration No. S-1205
(County Surveyor, Registered Land Surveyor, or other duly authorized official)

Office of Register of Deeds, County of....., I hereby certify that the within instrument was filed in this office for record on the..... day of....., 19..... at..... o'clock..... M.

.....
(Register of Deeds)

By..... Deputy