

CERTIFIED LAND CORNER RESTORATION


Index No. E-13

State of Wisconsin }
County of Lincoln } ss.

I Sheridan D. Schwark, do hereby certify that on the 12th day of April, 1978, I found evidence of the southwest corner of Section 3 Township 31, North, Range 6 East, Fourth, Principal Meridian, as described hereon; and that from this evidence I established a new monument and accessories as described hereon to perpetuate the original location of this corner.

Resident witnesses:

.....
.....
.....

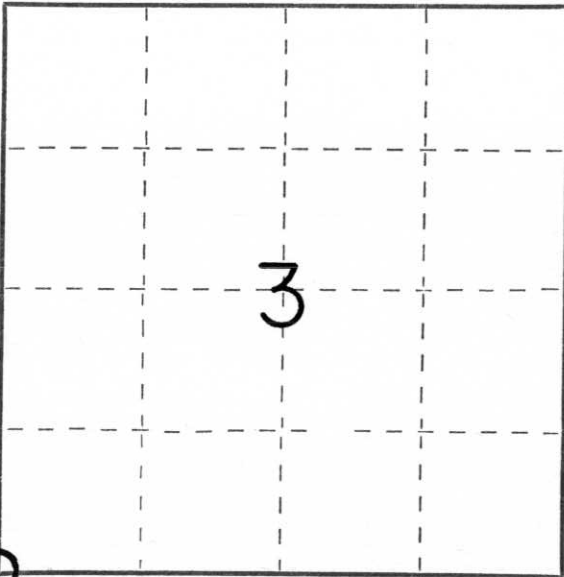

○ = Corner monument restored.

History of original corner establishment:

Date: March, 1852
Surveyor: Albert & Frederick Ellis
Monument: Wood post
Witnesses: 14" Hemlock, N57°E, 3 links
14" " , S66°W, 33 links

Description of corner evidence found:

We dug in the road to a depth which was lower than the natural grade and found nothing. We then reset the corner by using the one-quarter to the west and the one-quarter corner to the south as shown on a survey by Ray H. Hall on October 31, 1939 for the Council Grounds State Forest. The above map is on file at the Lincoln County Surveyor's office in the Court-house.

Description of monument and accessories I established to perpetuate the original location of this corner.

Set a Lincoln County Berntsen Monument with the following witness monuments:
1 1/4" x 30" iron pipe set at Northeast edge of the blacktop road, bearing N33°E, 16.65'
1 1/4" x 30" iron pipe set 3' north of stop sign bearing N38°W, 43.20'
1 1/4" x 30" iron pipe set 3' east of power pole 3106-9E4, bearing S36°W, 56.95'
1 1/4" x 30" iron pipe set 3' east of stop sign bearing S27°E, 36.39'

Dated at Merrill, Wis., this 14th day of April, 1978.

Signature Sheridan D. Schwark Title Registered Land Surveyor Registration No. S-1205
(County Surveyor, Registered Land Surveyor, or other duly authorized official)

Office of Register of Deeds, County of....., I hereby certify that the within instrument was filed in this office for record on the.....day of....., 19..... at.....o'clock..... M.

.....
(Register of Deeds)

By.....Deputy