




SCALE: 1"=1000'
 0 500' 1000'

- LEGEND**
- (M) MEASURED DISTANCE
 - (R) RECORD HIGHWAY STATIONING DISTANCE FROM HIGHWAY FIELD NOTES
 - EXISTING PK NAIL
 - ▲ EXISTING BERTNSEN SURVEY MARK NAIL
 - △ SET BERTNSEN SURVEY MARK NAIL
 - HWY HIGHWAY STATIONING DISTANCE FROM RIGHT OF WAY PLAT DIVISION JOB NO. 7035

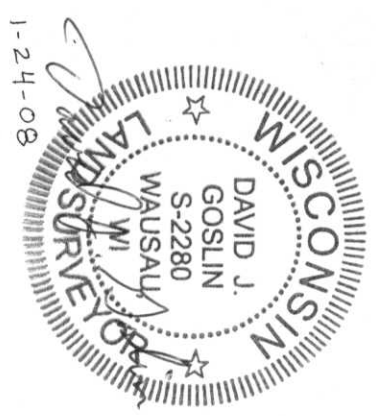

PROPORTION FOR SOUTHEAST CORNER SECTION 8
 $(M) 5271.99' = \frac{2639.99'}{2642.00'} = \frac{2632.00'}{2634.00'}$
 HWY 5276.00' = 2642.00' = 2634.00'

