

CERTIFIED LAND CORNER RESTORATION

Index No. G-17

State of Wisconsin }  
County of Lincoln } ss.

History of original corner establishment:

Date: March, 1852  
Surveyor: A.G. & F.S. Ellis  
Monument: Wood post  
Witnesses: 30" Pine, S67°E, 26 links  
6" Birch, N12°W, 37 links

I Sheridan D. Schwark, do hereby certify that on the 19th day of July, 1978, I found evidence of the East one-quarter corner of Section 10 Township 31, North, Range 6 East, Fourth, Principal Meridian, as described hereon; and that from this evidence I established a new monument and accessories as described hereon to perpetuate the original location of this corner.

Description of corner evidence found:

We re-established the corner by re-establishing the 1/16th corner to the north from information shown on the plat of S. Heineman's Second Addition. By doubling the distance on a straight line to re-establish the one-quarter corner it falls in an area which looks correct according to the plat of H.W. Wright Lumber Co. Addition. H.W. Wright Lumber Co. Addition had no remaining monuments to enable us to re-establish the corner and all witnesses in the area had conflicting stories as to the original location.

Resident witnesses:

.....  
.....  
.....

Description of monument and accessories I established to perpetuate the original location of this corner.



A LINCOLN COUNTY BERNTSEN MONUMENT WAS SET .4' BELOW LAWN SURFACE AND ± 2' NORTHEAST OF FACE OF HOUSE



P.K. SET IN TOP OF CURB 25.55' NORTHWEST OF NORTHERLY EDGE OF WALK

WOOD CORNER OF HOUSE = N58°W, 4.04'

FRONT NORTHWEST CORNER OF TOP STEP = S17°E, 6.04'

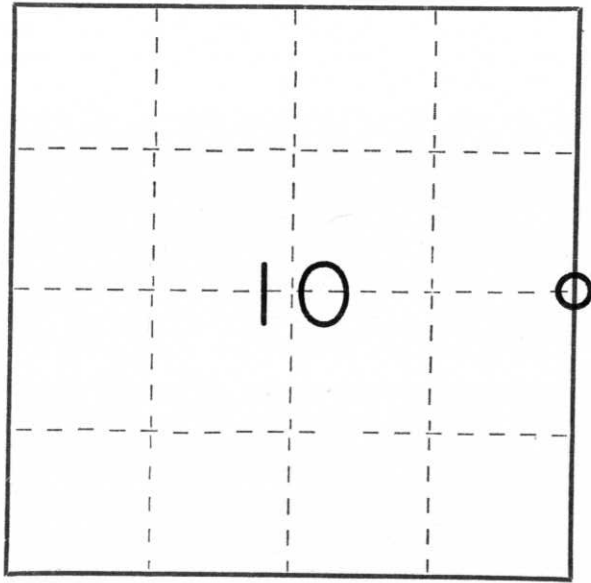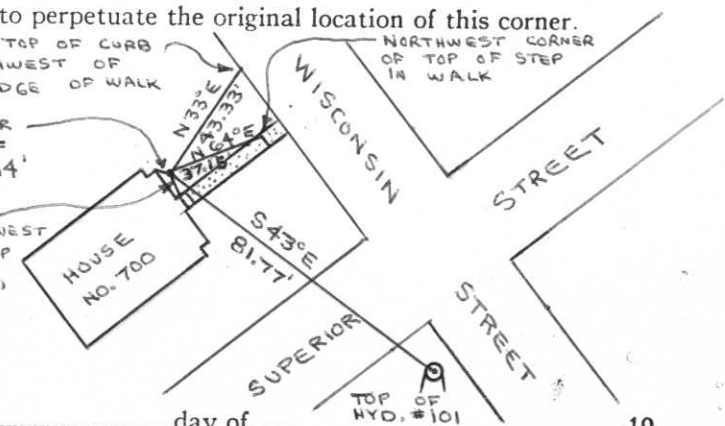

○ = Corner monument restored.

MERRILL, Wis

Dated at AUG. 7, 1978, Wis., this ..... day of ..... 19.....

Signature Sheridan D. Schwark Title Registered Land Surveyor Registration No. S-1205  
(County Surveyor, Registered Land Surveyor, or other duly authorized official)

Office of Register of Deeds, County of ....., I hereby certify that the within instrument was filed in this office for record on the ..... day of ....., 19..... at ..... o'clock ..... M.

(Register of Deeds)

By ..... Deputy