
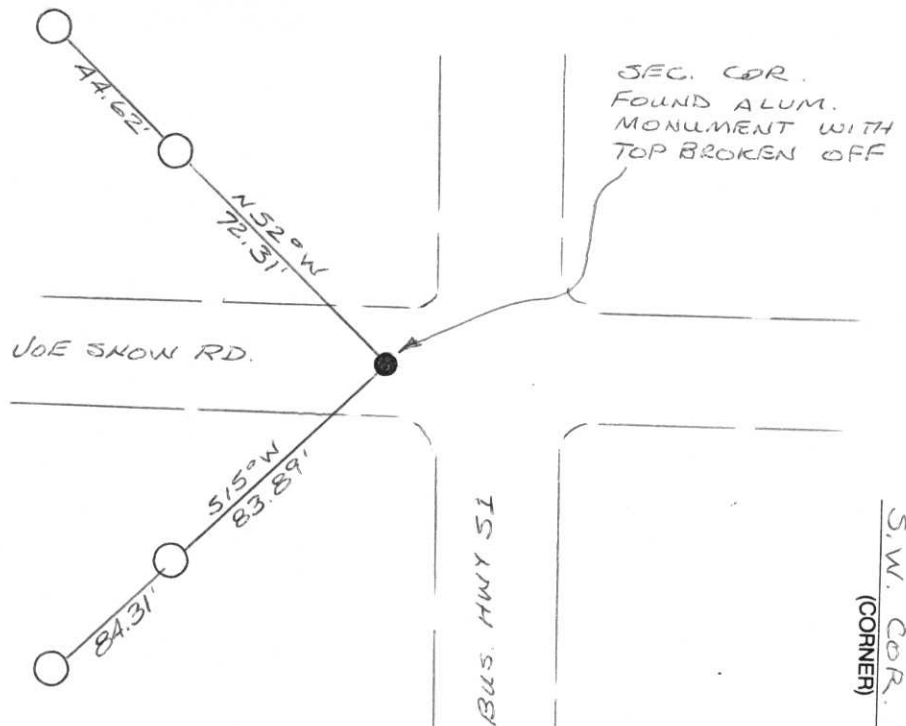


RECORD AND CERTIFICATION OF U.S. PUBLIC LAND SURVEY CONTROL STATION

ED716 687

District 7	Project ID 9675-05-00	Located By R.B. JOHNSON - SURVEY CREW CHIEF			
Corner S.W. COR. SEC. 13	Township 31N	Range (E,W) 6E	County LINCOLN		
Wisconsin Coordinates	East (X)	North (Y)	Elevation (Z)	Zone	
Control Station Name	East (X)	North (Y)	Elevation (Z)	Zone	
Horizontal - NORTH AMERICAN, 1927		CONTROL DATUM Vertical - MEAN SEA LEVEL, 1929 ADJUSTMENT			
Horizontal - _____ Order _____		SURVEY CONTROL Vertical - _____ Order _____			

SKETCH

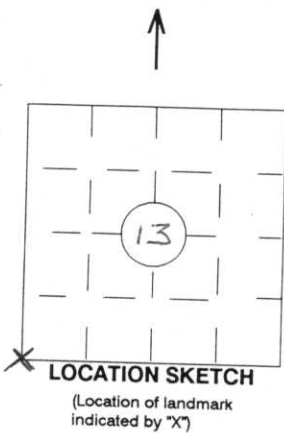

I hereby certify that on the date of APRIL 1, 1996
the above corner was located by a marker and/or references established by
EDWIN ABENDROTH 5-798
(registered land surveyor) (registration no.)

I further certify that to perpetuate the location of said corner, on the date of
APRIL 1, 1996 at the exact location thereof,
a permanent marker or witness monuments consisting of
FOUR 3"X30" BERNTSEN MAGNETIC
ALUMINUM MONUMENTS
were located as shown above.

Signature (District Survey Supervisor)

Dave Fisher

RECEIVED AT LINCOLN COUNTY
COURTHOUSE THIS 17 DAY
OF APRIL 1996
TAX DESCRIPTION OFFICE

S.W. COR.
(CORNER)
13
(SECTION)
31N
(TOWN)
6E
(RANGE)


FIELD SURVEY NOTES

PRESERVATION OF LANDMARKS


(Pursuant to Section 59.635(7) Wisconsin Statutes
E-D-707-69

State of Wisconsin / Department of Transportation


COUNTY		
TOWN		
HIGHWAY		
SECTION	TOWNSHIP	RANGE
TYPE OF LANDMARK		

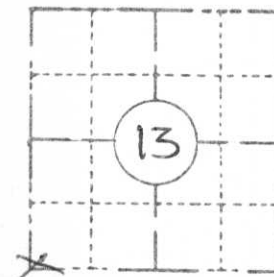

LOCATION SKETCH
(Location of landmark indicated by "x")

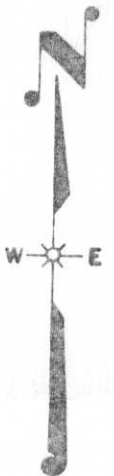

This space for copy of field notes or ties to the above described landmarks

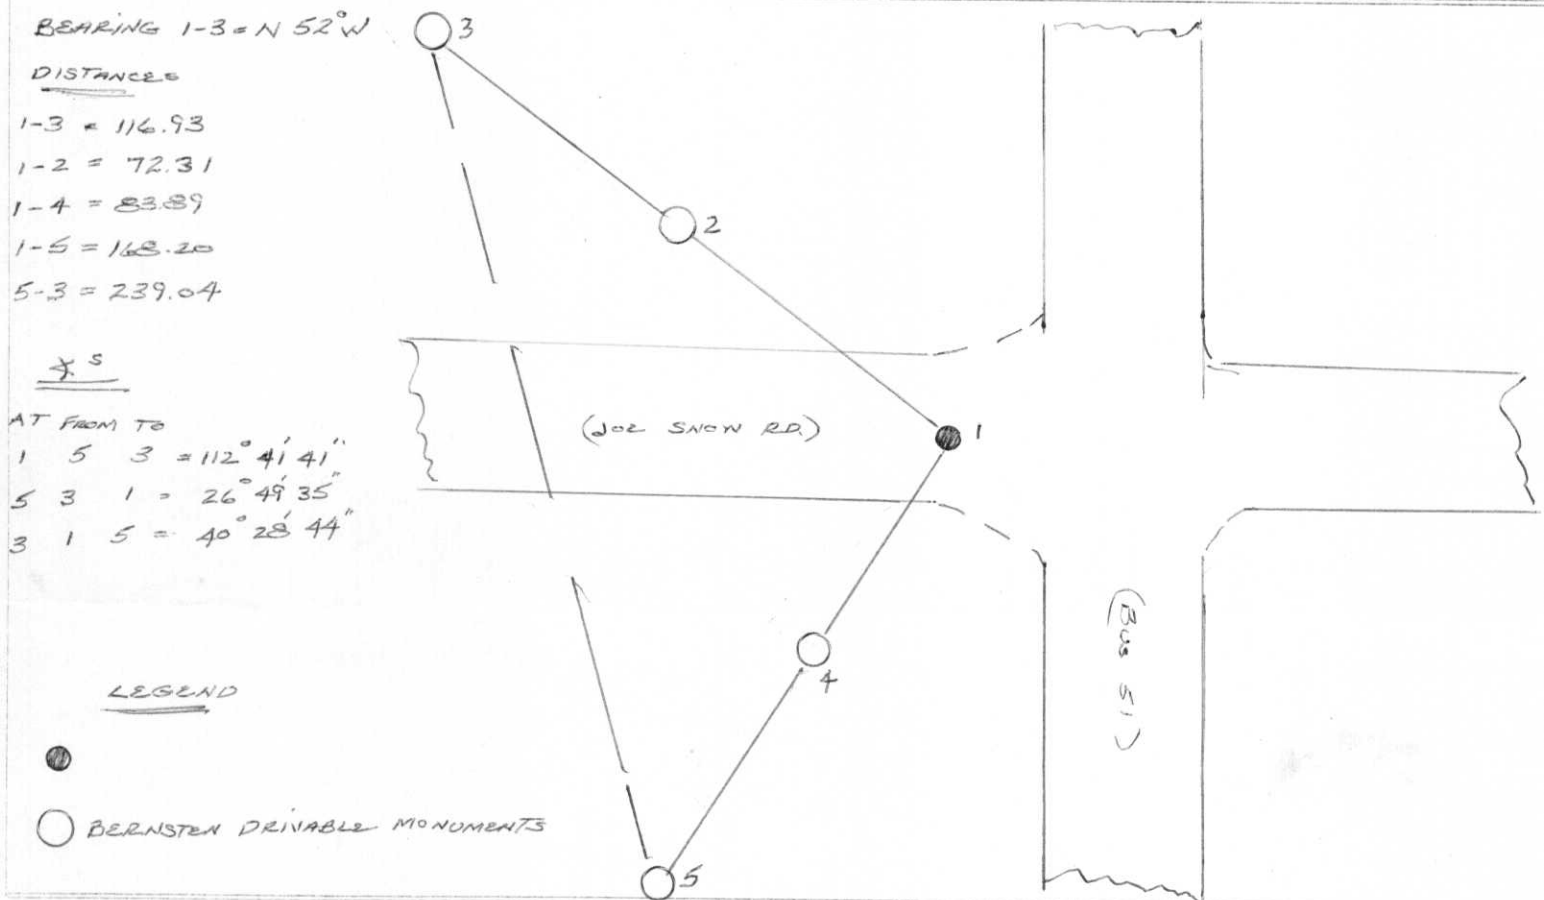

FILED UNDER PROJECT		COUNTY CLERK'S OFFICE	
DISTRICT OFFICE NUMBER		COUNTY OF	WISCONSIN } SS
LOCATED OR ESTABLISHED BY		DATE RECEIVED FOR RECORD	DATE COPY SENT TO COUNTY SURVEYOR
NAME		SIGNATURE OF COUNTY CLERK	
TITLE		4-17-1997	

RECEIVED AT LINCOLN COUNTY COURTHOUSE THIS 17 DAY OF 1997

TAX DESCRIPTION OFFICE

Property TAX Coordinator

U.S. PUBLIC LAND SURVEY MONUMENT RECORD


Note: This form is intended and designed to fulfill all requirements of Wisconsin Administrative Code, Chapter A-E 5.02, U.S. Public Land Survey Monument Record (3) (a) (b) (c) (d) (e) (f) (g) (h) (i). An additional sheet may be added if necessary to conform with said requirements.

(a) Corner location: Township 31 North

Range 6 East

Town Merrill

County Lincoln

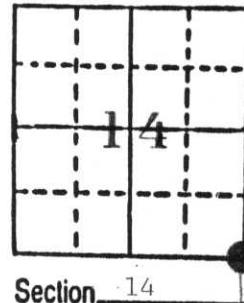


Section 14

b) (f) (g) (h) Description of monument found at this corner and if it was accepted, state all evidence (material, testimonial, occupational, plats, records, other monuments) used as a basis for accepting. If not accepted or if nothing was found, state evidence used as basis for establishing location. If reestablished through lost corner proportionate methods, indicate all monuments, distances and directions used to establish.

The Lincoln County Berntsen Monument which marks this corner was placed by Ed Abendroth, Registered Land Surveyor, on Sept. 20, 1976. When we attempted to use this corner we found that the corner was still in place approximately 1' under the road surface, however three of the references had been destroyed. Therefore we established the following references for the already existant corner.

c) (d) (e) Plan view of corner with ties to at least 4 witness monuments. If in disagreement with previously established corner, show the distances between the two corners and also indicate the ties to the disputed corner.

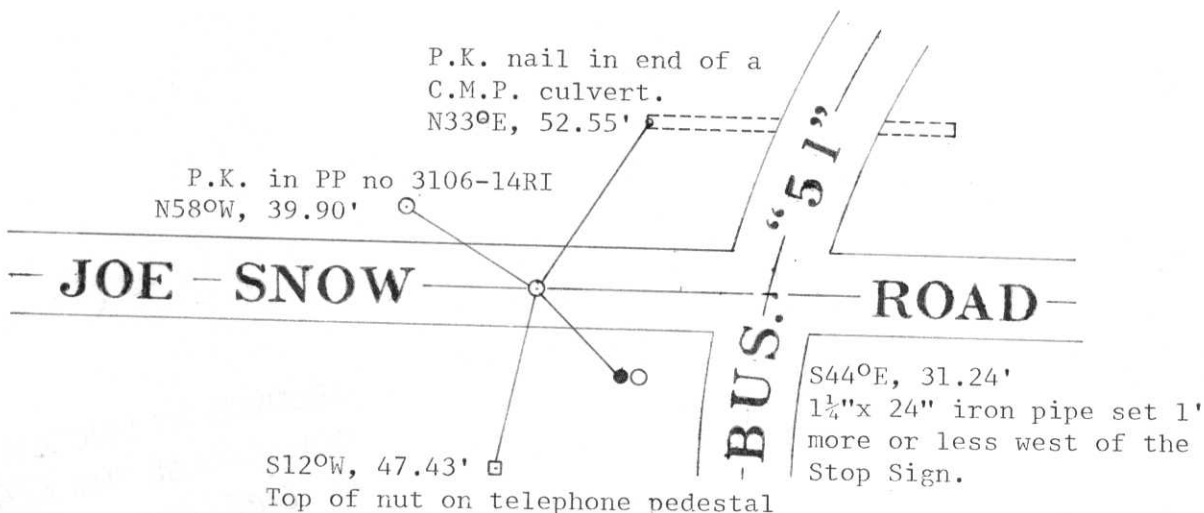

(i) I, Sheridan D. Schwark

(type or print name) certify that the corner location on this record was determined by me or under my direction and control and that this U.S. Public Land Survey Monument Record is correct and complete to the best of my knowledge and belief.

Sheridan D. Schwark

Signature

October 3, 1985

Date




Index No. M-21

State of Wisconsin }
County of Lincoln } ss.

I Edwin R. Abendroth, do hereby
certify that on the 10th day
of Sept., 1976, I found
evidence of the SE
corner of Section 14
Township 31, North, Range
6 E, Fourth, Principal Meridian,
as described hereon; and that from this evidence
I established a new monument and accessories
as described hereon to perpetuate the original
location of this corner.

Resident witnesses:

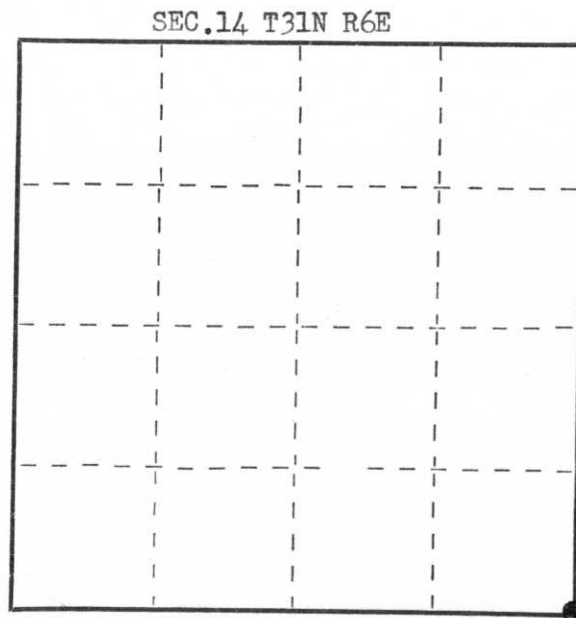

○ = Corner monument restored.

CERTIFIED LAND CORNER RESTORATION

Index No. M-21

History of original corner establishment:


Wooden Post was established at the corner location as the result
of the original Gov't. survey. No positive evidence of the original
corner was discovered.

A stone monument was established during a remonumentation program.
We did not find any evidence of this stone monument.

Description of corner evidence found:

As we excavated with the backhole we uncovered several broken, rotted pieces
of an old wood post. We also discovered broken pieces of crockery scattered
about the excavation site. However We were unable to determine the source
of this material. We made the determination that the corner was lost.

Description of monument and accessories I established to perpetuate the original location of this corner.

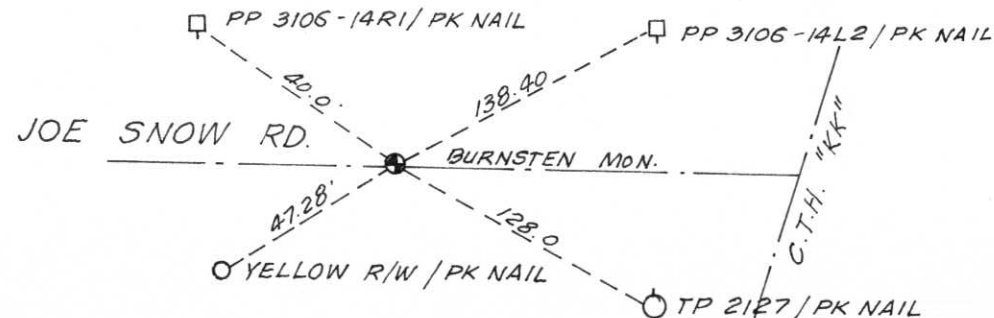

Dated at Wausau, Wis., this 20th day of September, 1976

Signature Edwin R. Abendroth Title Reg. Land Surveyor Registration No. S-798
(County Surveyor, Registered Land Surveyor, or other duly authorized official)

Office of Register of Deeds, County of Lincoln, I hereby certify that the within
instrument was filed in this office for record on the _____ day of _____, 19____
at _____ o'clock _____ M.

(Register of Deeds)

By _____ Deputy